


SALEM
 34483 DEERWOOD DRIVE
 EUGENE, OR 97405

OREGON
 00'
 FEET




For X iron pins marking the east corner of Sec. 25 - T185 - R3W - W4

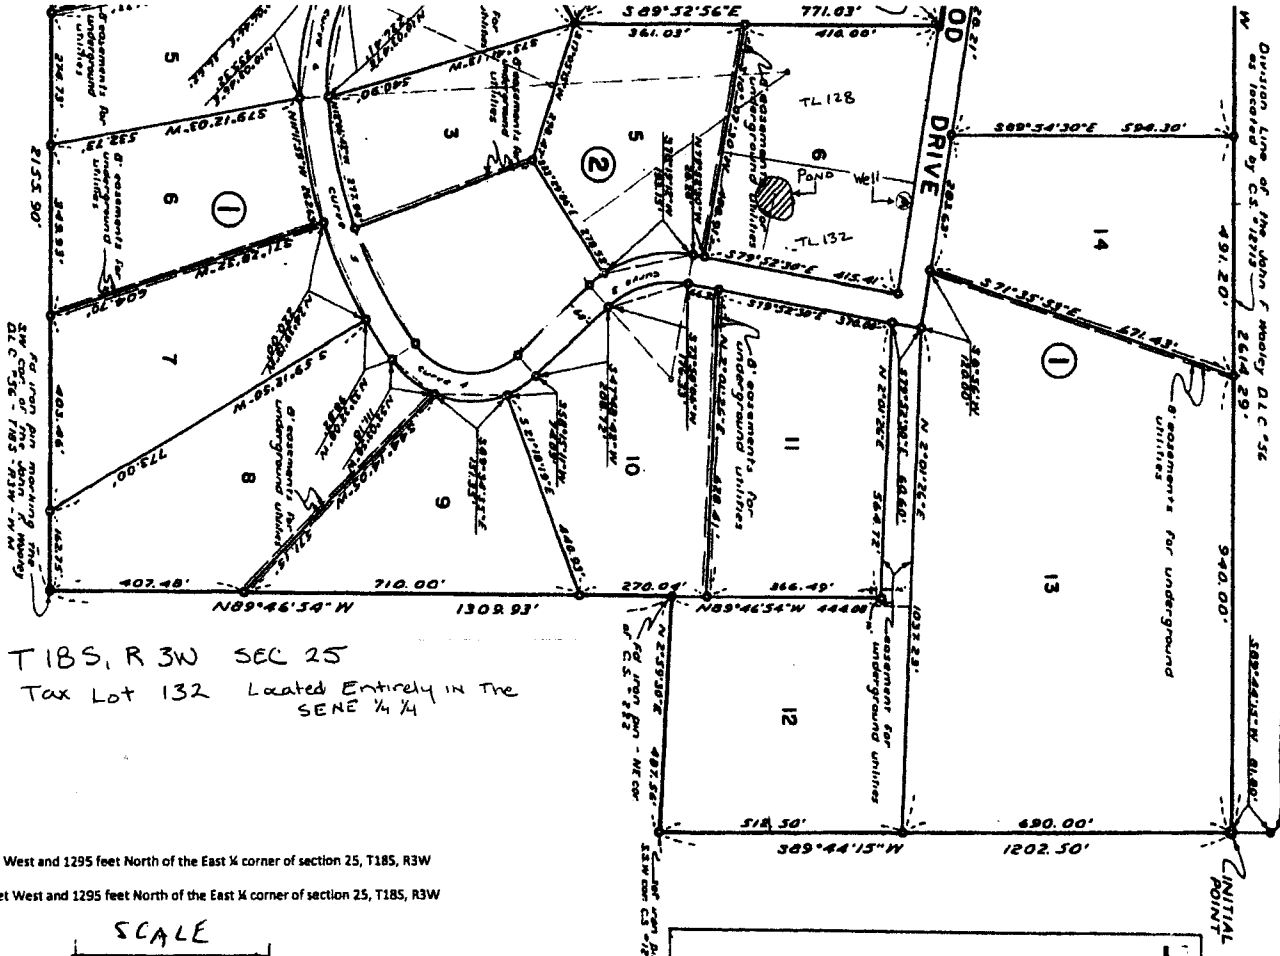


T185, R3W SEC 25
 Tax Lot 132 Located Entirely in the
 SENE 1/4 1/4

Well located 690 feet West and 1295 feet North of the East 1/4 corner of section 25, T185, R3W
 Pond Located 965 Feet West and 1295 feet North of the East 1/4 corner of section 25, T185, R3W

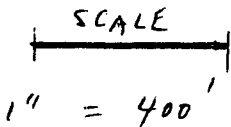

ENLARGEMENT
 OF
 SUBJECT
 PROPERTY

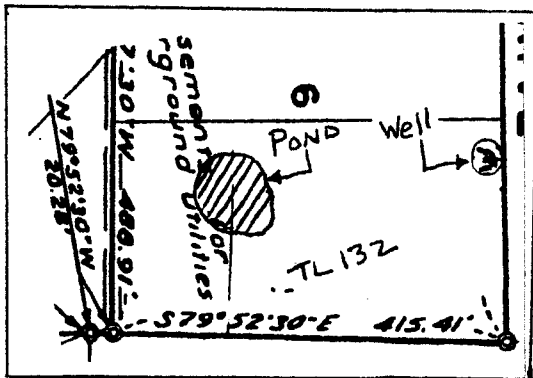

RECEIVED BY OWRD

APR 24 2015

SALEM, OR

R-88074