


T 20 S, R 5 W, Sec 20

Tax Lot 302

Ponds in NE 1/4 NE 1/4

Pond 1 300' S, 1260' W

Pond 2 430' S, 1290' W From NE Sec Corner

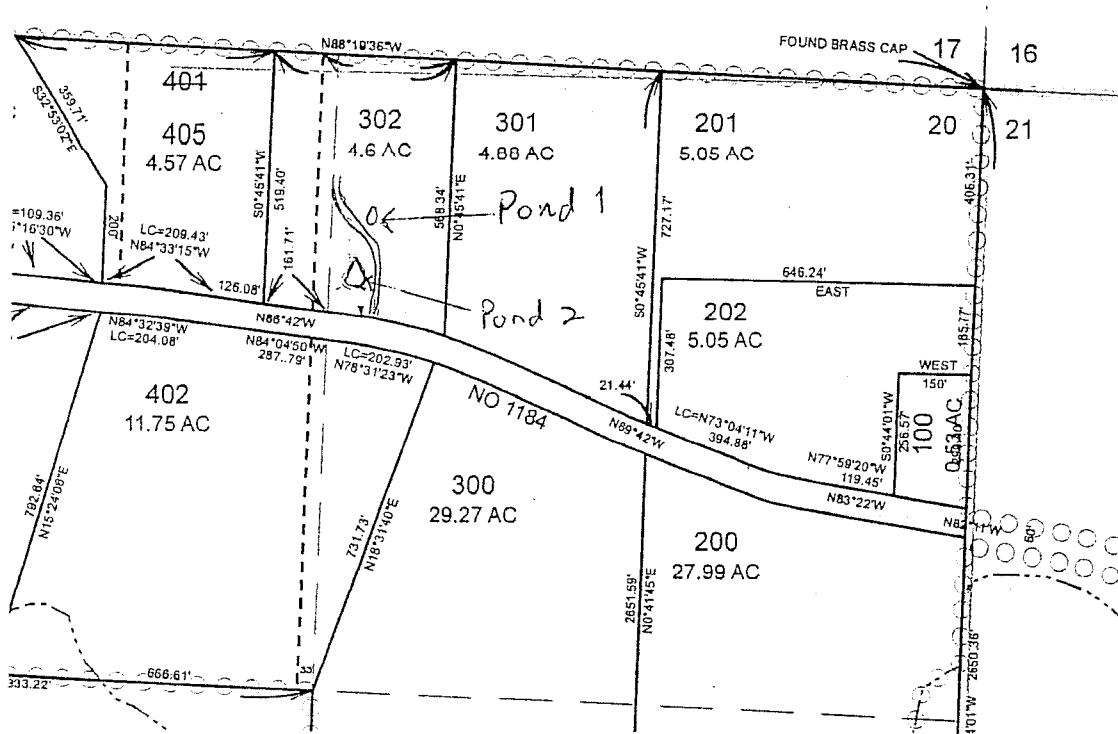

1" = 400'

Steve Haney

BPRM


LMD staff can NOT be held responsible for evaluations based on false, inaccurate or incomplete information.

SCANNED

Date: 02-04-2008
Initials: SATG

SITE PLAN SUBMITTAL FORM

OWNER NAME: STEPHEN & ELIZABETH HANEY	Map and Taxlot #: 20.05.20.00.00302	APPLICANT NAME: STEPHEN & ELIZABETH HANEY
PHONE #: (541) 255-2859		PHONE #: (541) 255-2859
ADDRESS: 25811 SIUSLAW RIVER RD. LORANE, OREGON 97451	Scale: 1" = 50'	ADDRESS: 25811 SIUSLAW RIVER RD. LORANE, OREGON 97451

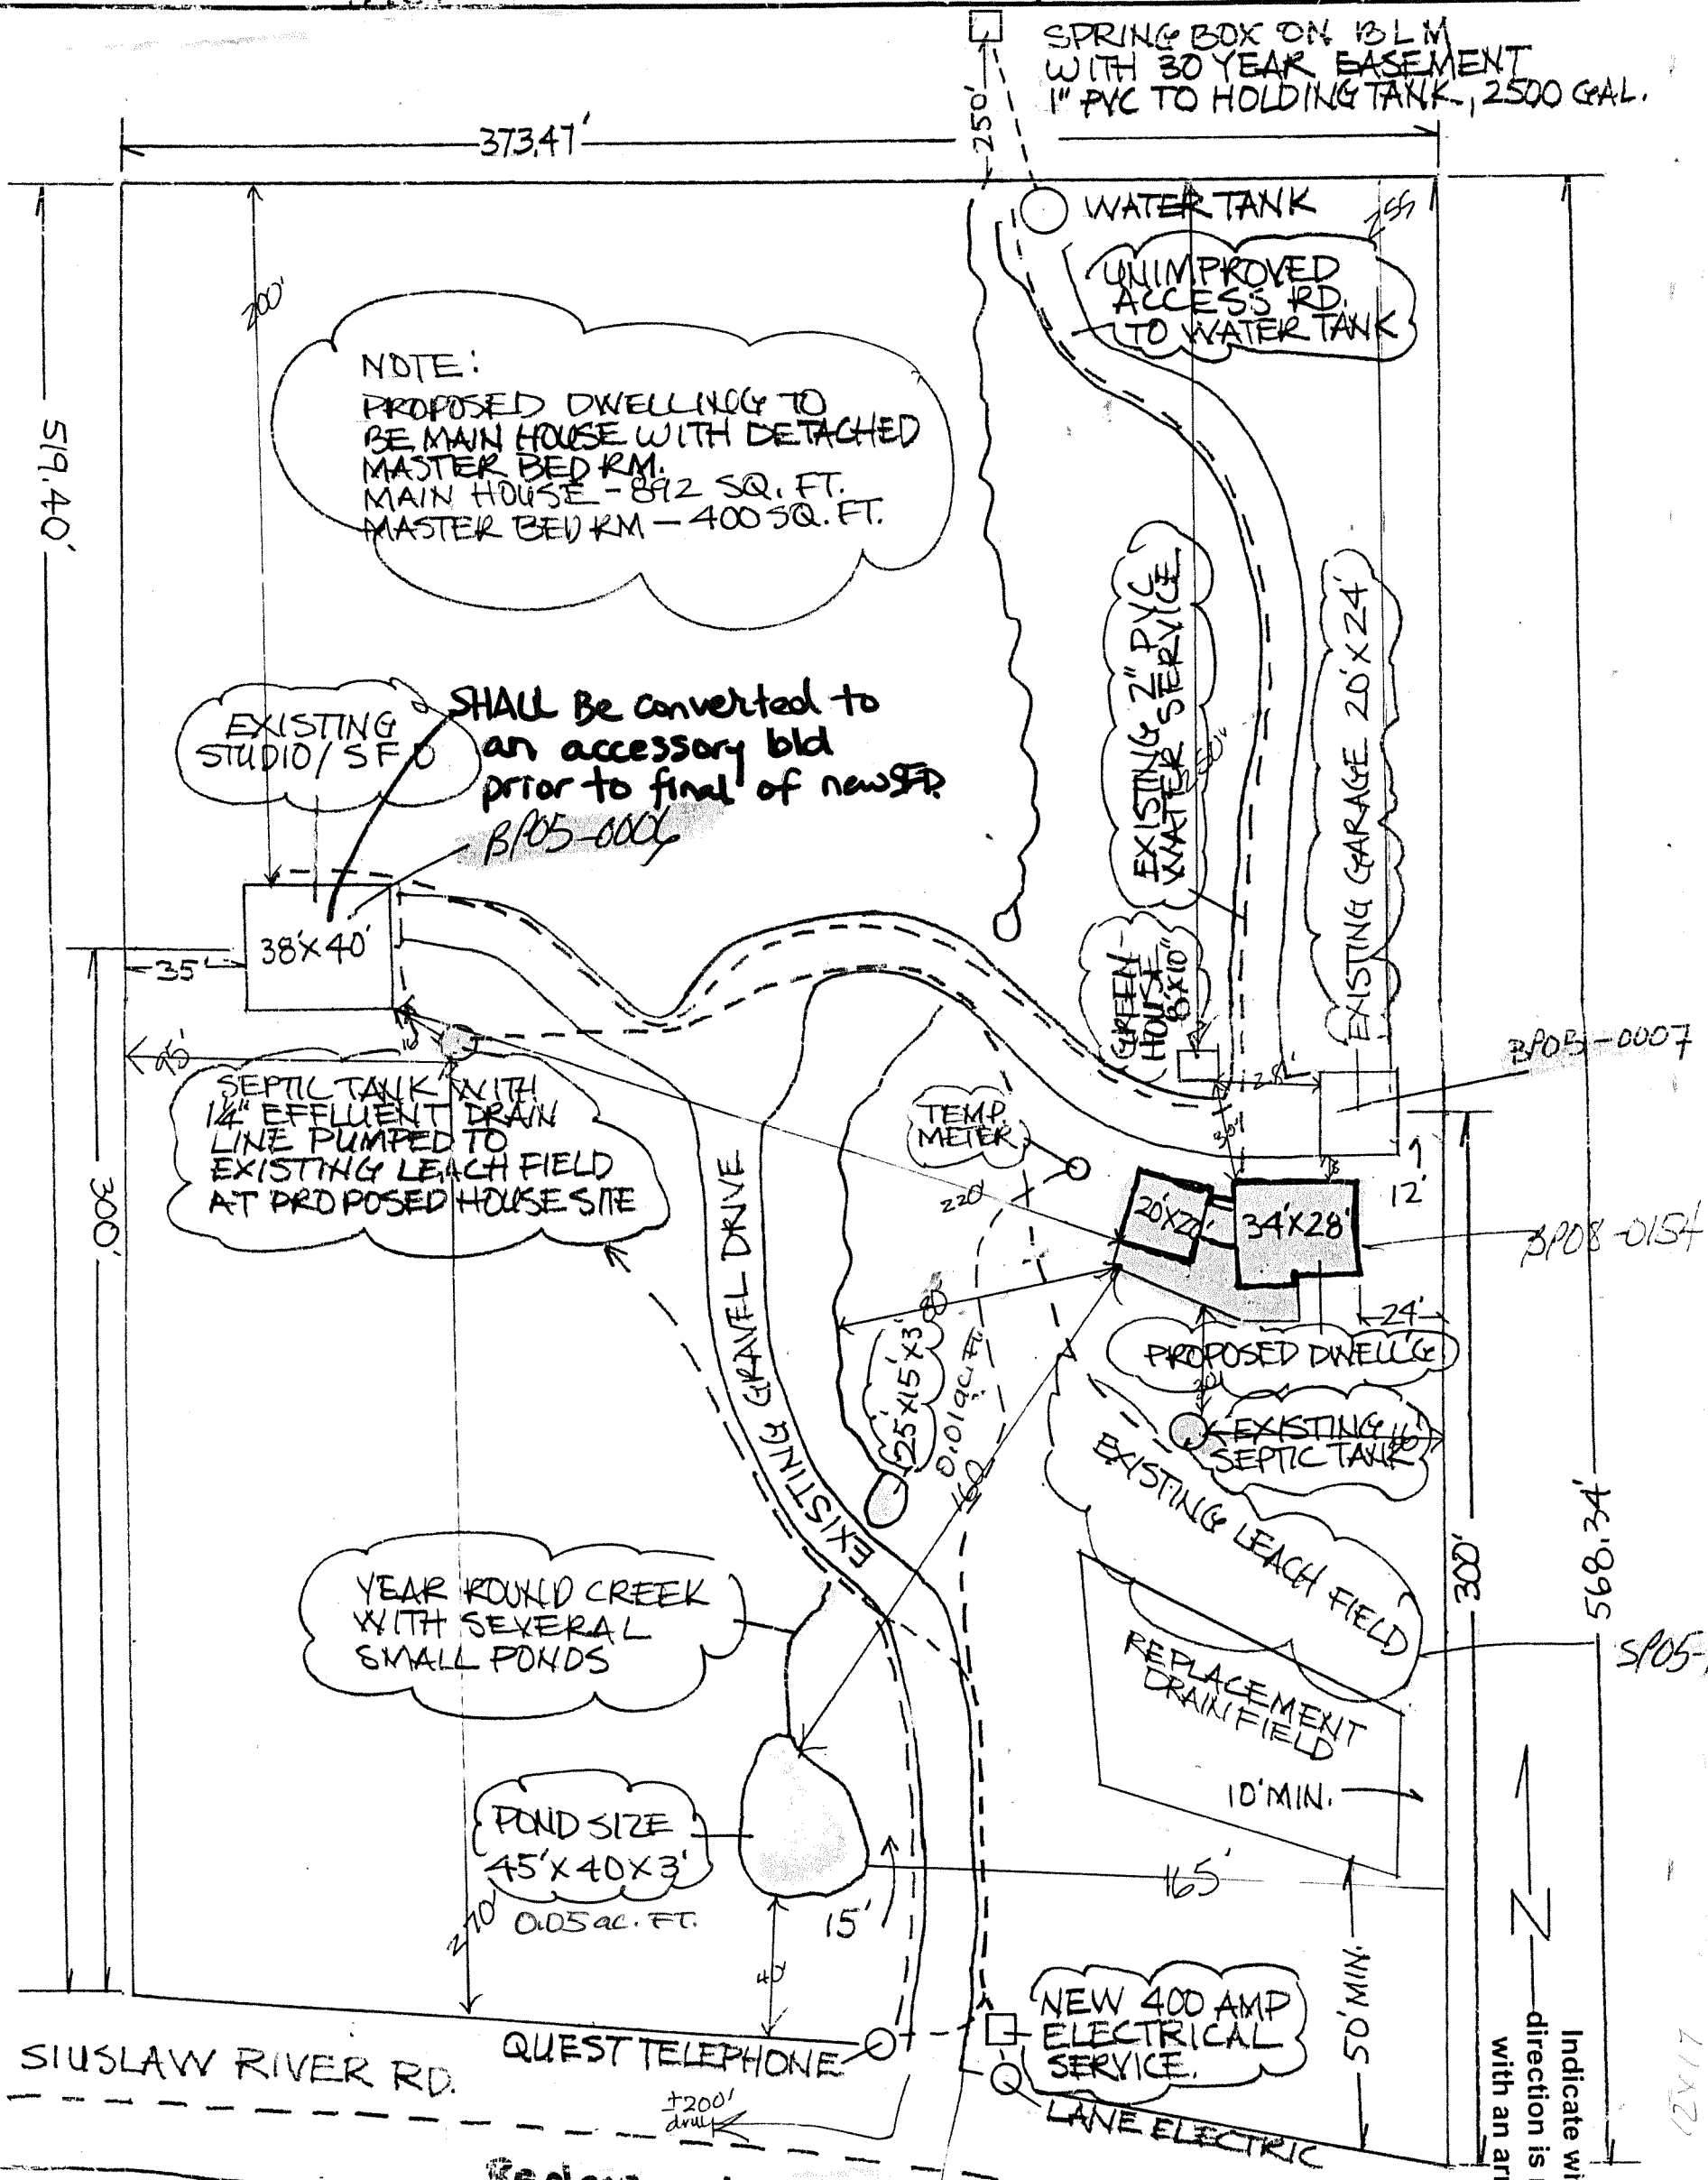

BPO8-0154
PLOT PLAN ACCEPTED
SFD 02-04-2008

Replacement SFD
BP 08-0154
PLANNING STAFF/CITY DATE 02/04/08 INITIALS SSH

RECEIVED
OCT 22 2014
OWRD

Indicate which direction is north with an arrow

11x21