


T 20 S, R 5 W, Sec 20

Tax Lot 302

Ponds in NE 1/4 NE 1/4

Pond 1 300' S, 1260' W

Pond 2 430' S, 1280' W from NE Sec Corner

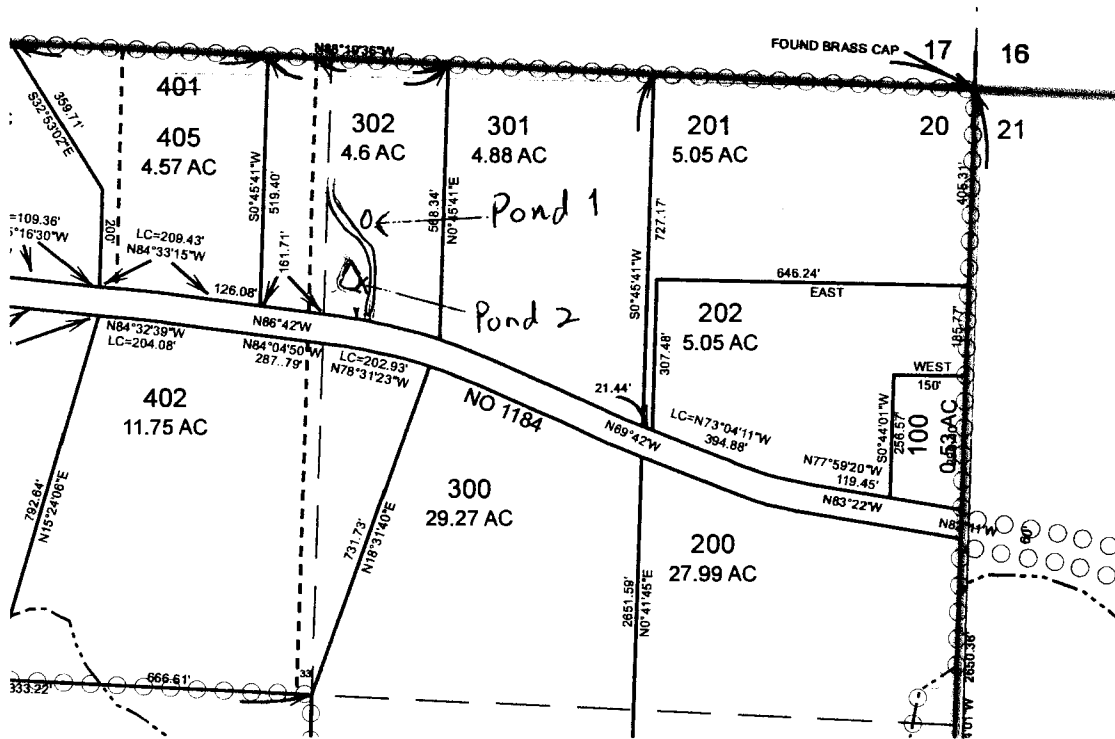

1" = 400'

R-88025-

RECEIVED
OCT 22 2014
OWRD