


SECTION PLAT

Section 7 Township 17S Range 31E

County of Grant State of Oregon

NORTH

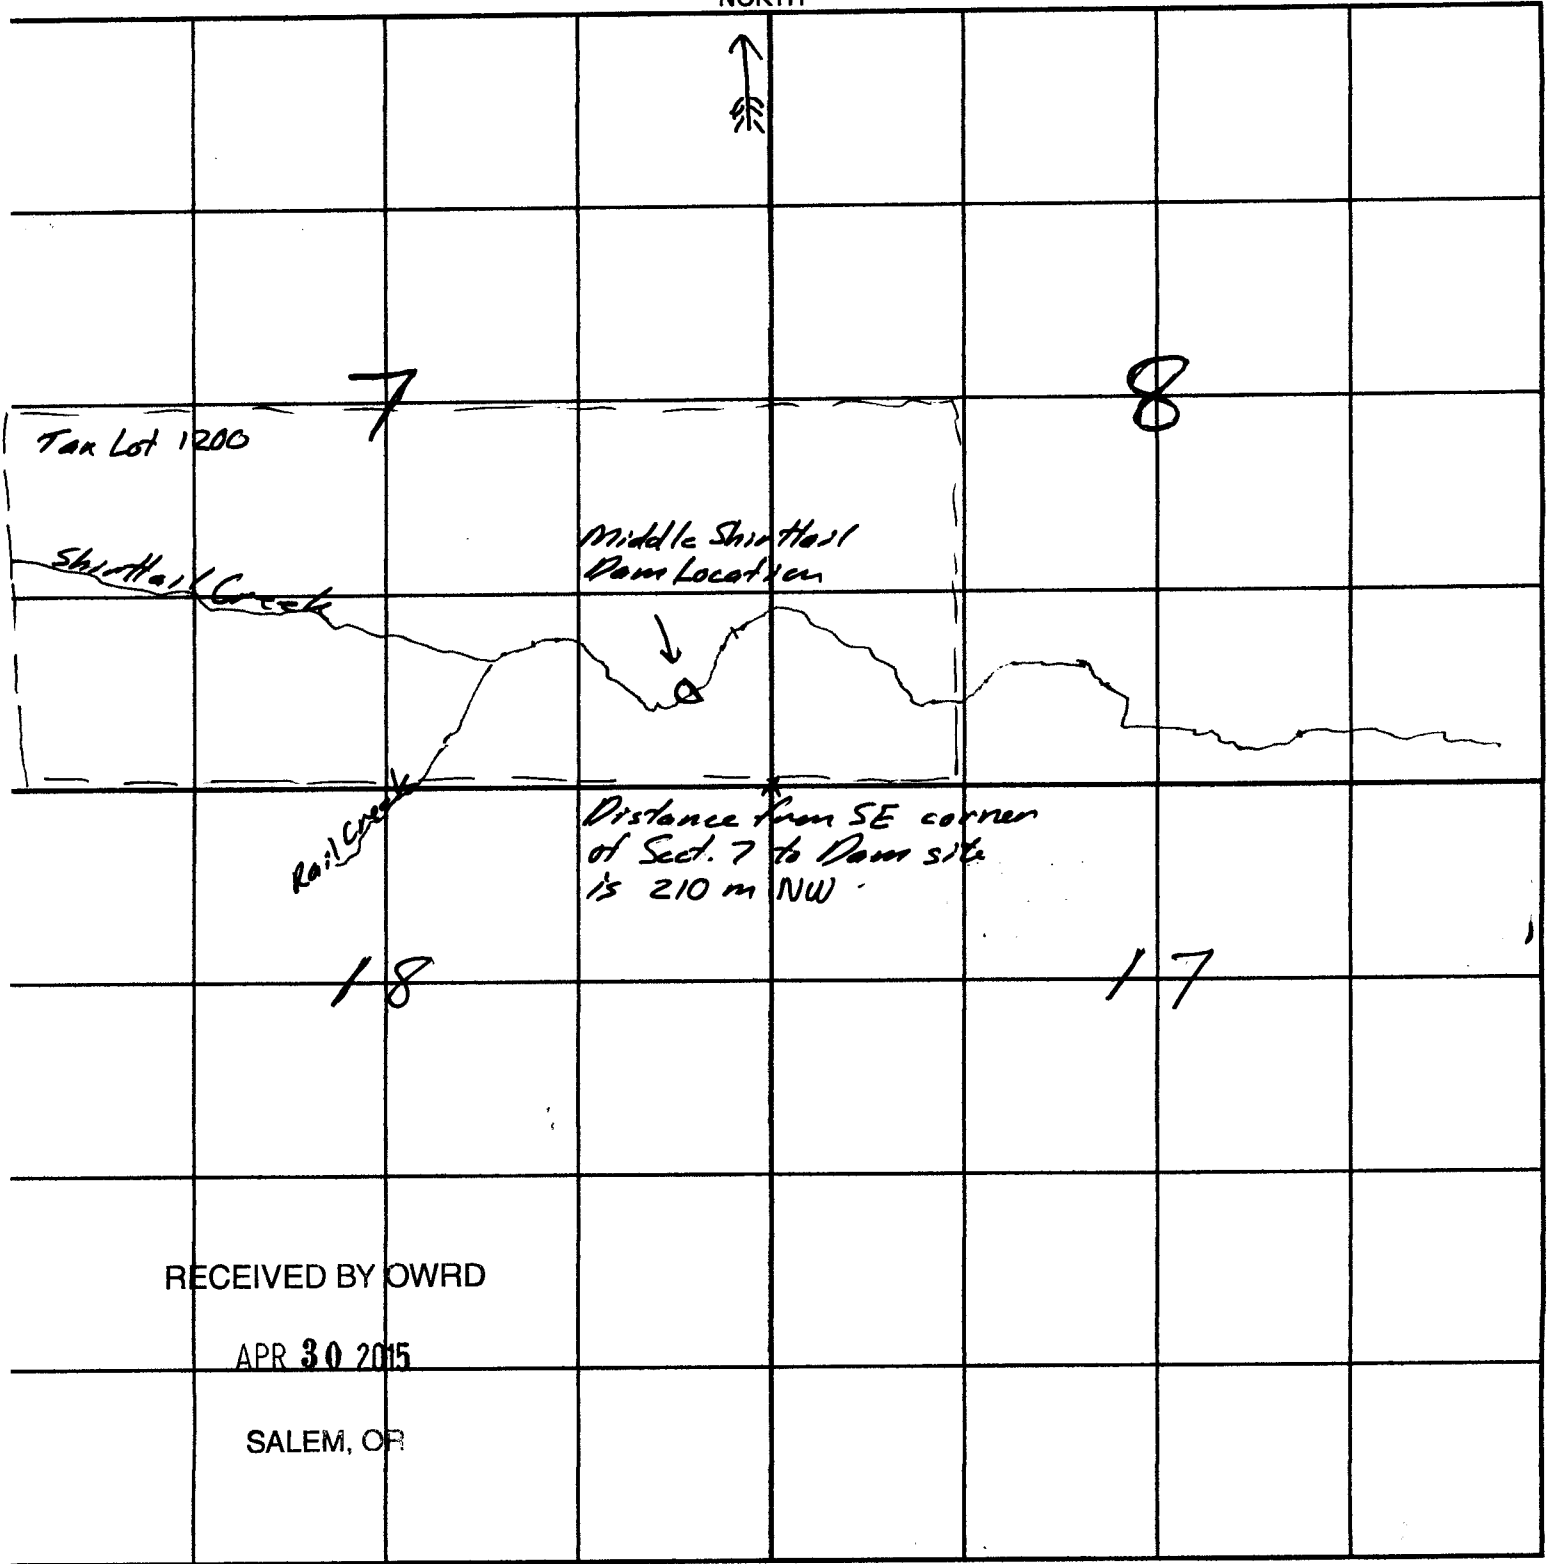

RECEIVED BY OWRD

APR 30 2015

SALEM, OR

R-98094

4"=1 mile