


Eldon Metz, Cascade Buffalo Ranch

1" = 1320'

Tax Lot: 300



Township 8 South, Range 1 West, Section 8

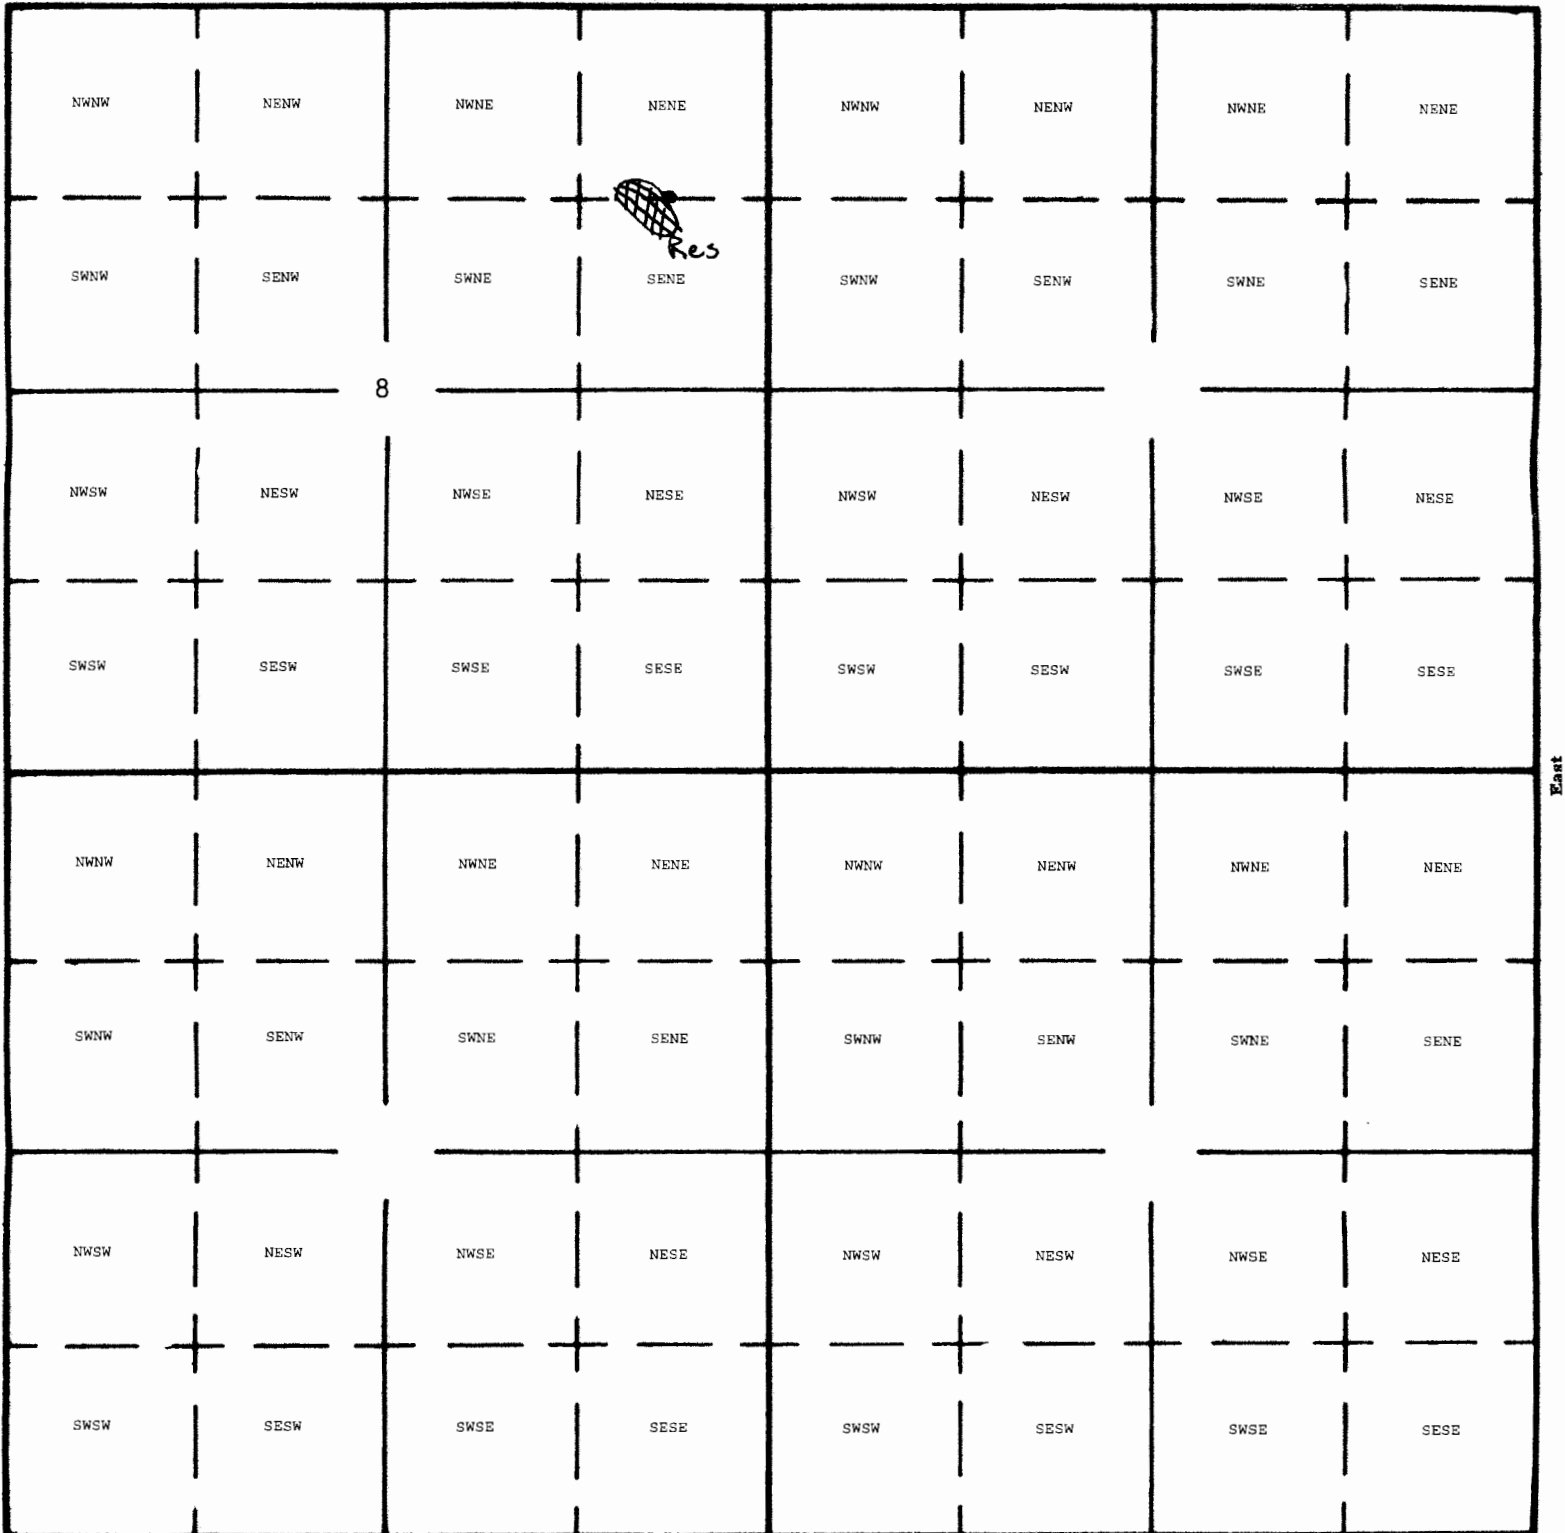

Center of Dam: 1320 Feet South and 700 Feet West from the NE Corner Section 8

*E/M* RECEIVED BY OWRD

3/25/15 MAY 05 2015

*R-2800*

SALEM, OR