

T 20 S, R 3 W Sec 14
NE 1/4, NW 1/4

TAX MAP LOT 20 03 11 00 00 500
& 503

pond outlet is 130 ft. south
and 2,330 ft West from
SE cor DLC 48 in Sec. 11


Travis Harrold



RECEIVED BY OWRD

JUN 09 2015

SALEM, OR

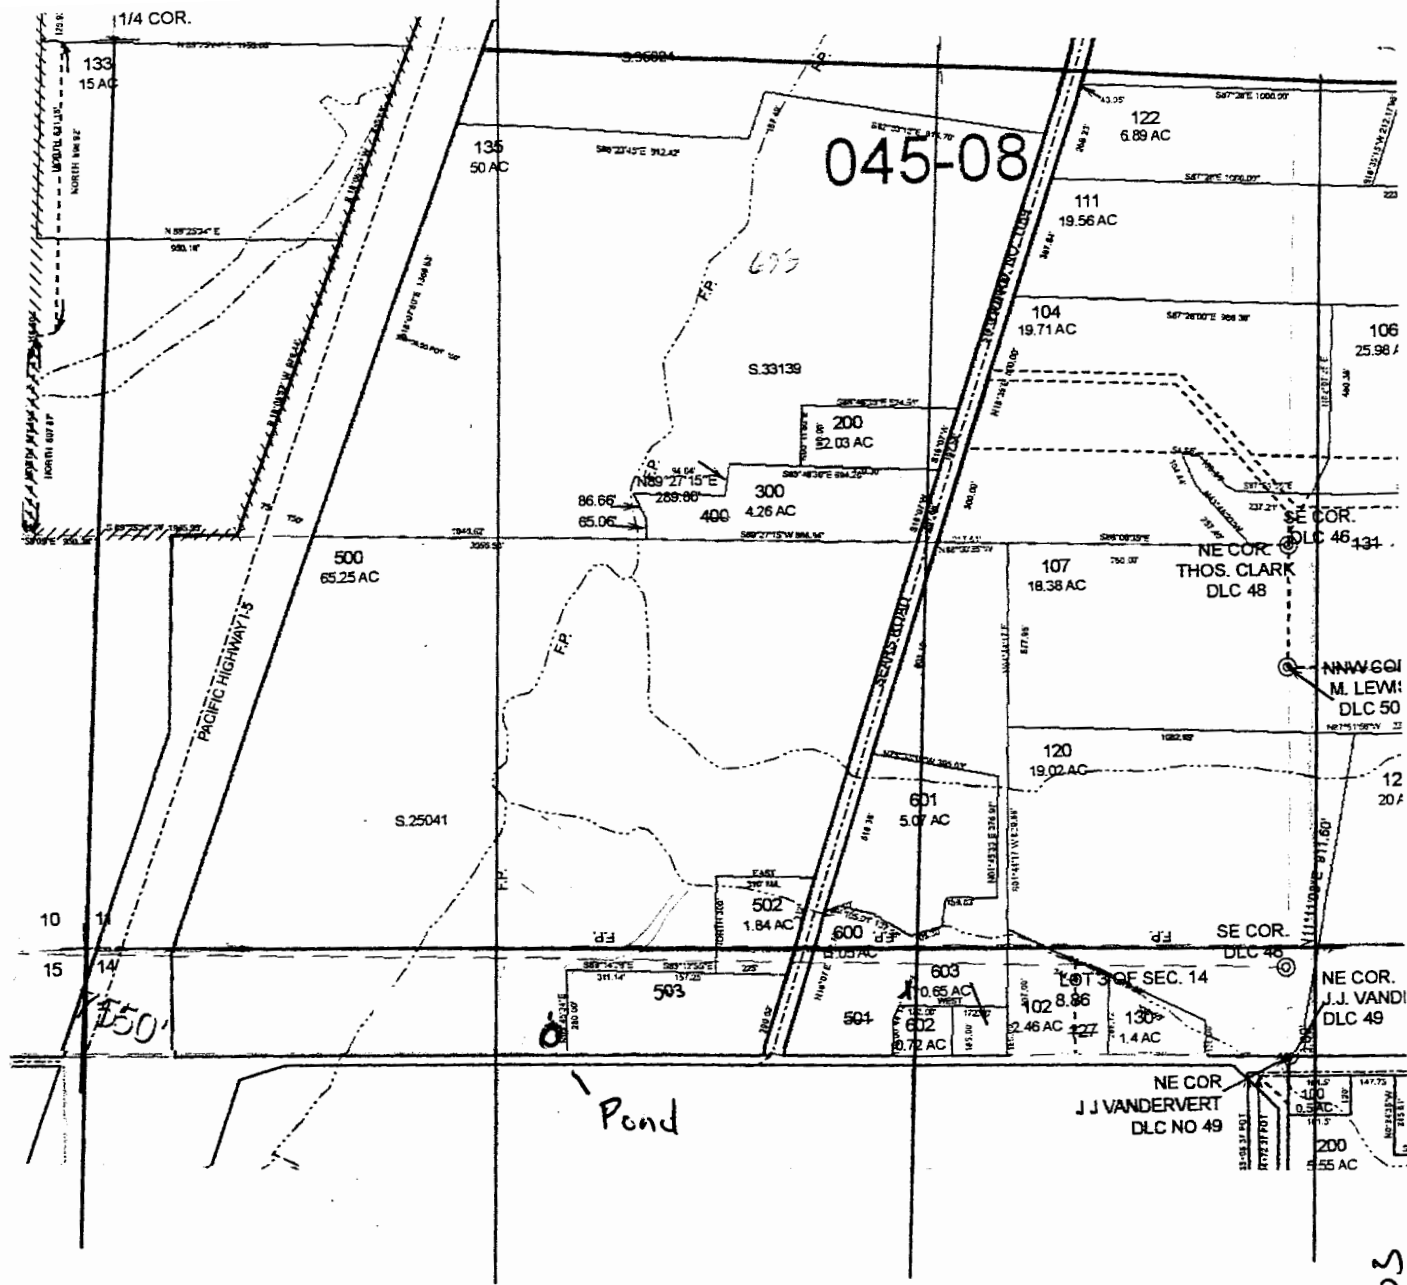

R-00103