

E 1/4 W 1/4

N88°53'12"E

5333.11'

# RECEIVED

SEP 28 2015

WATER RESOURCES DEPT  
SALEM, OREGON

## 9-5

RES. LOCATED:  
970 FT. NORTH  
1600 FT. EAST  
FROM  
SW COR. SEC. 32

N00°10'45"W  
1241.14'

1241.31'

1307.93'

N07°06'E  
1770.6'

1215.24'

1213.80'

1213.80'

1307.93'

400  
36.00 AC.

300  
22.87 AC.

301  
12.96 AC.

PARCEL 1

PARCEL 2

900  
10.20 AC.

1000  
4.68 AC.

500  
0.81 AC.

600  
38.87 AC.

1100  
20.00 AC.

HISTORICAL  
1/16 COR  
PORTION  
PARCEL 1

205 OS  
3.60 AC.

201  
290 OS

207  
15.60 AC.

204  
24.96 AC.

203 OS  
KILCHIS

01N09W32

01N09W31

N86°31'24"W

1287.85'

808.67'

518.7'

29.1'

616'

130.27'

130.27'

1213.80'

1213.80'

KILCHIS

PORTION

PARTITION

PARTITION

PLAT

2011-14

N04°02'1"E  
898.43'

N83°30'02"E  
577.14'

S41°59'5"E

200.86'

N09°50'17"E  
128.80'

S79°06'52"E  
703.18'

RIVER

SURFACE  
RUNOFF

KILCHIS  
RESERVOIR

ROAD

01N09W32D

PTN. PARCEL 1

PTN. P.P. 601 P.2  
2.80 AC.

602  
2.70 AC. 1996-88

P.3  
(OLD)

ROAD

RIVER

FOREST

603  
14.74 AC.

PLAT

2002-14

32

KILCHIS

700  
4.40 AC.

PARCEL 2


S 1/4

01S09W

1" = 400 FT.

SEE MAP 1S 9W

Tillamook  
COUNTY  
GIS

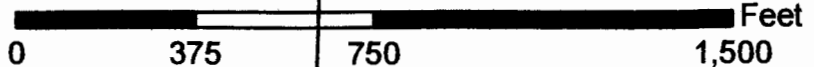

REELS