


This map was prepared for assessment purposes only.

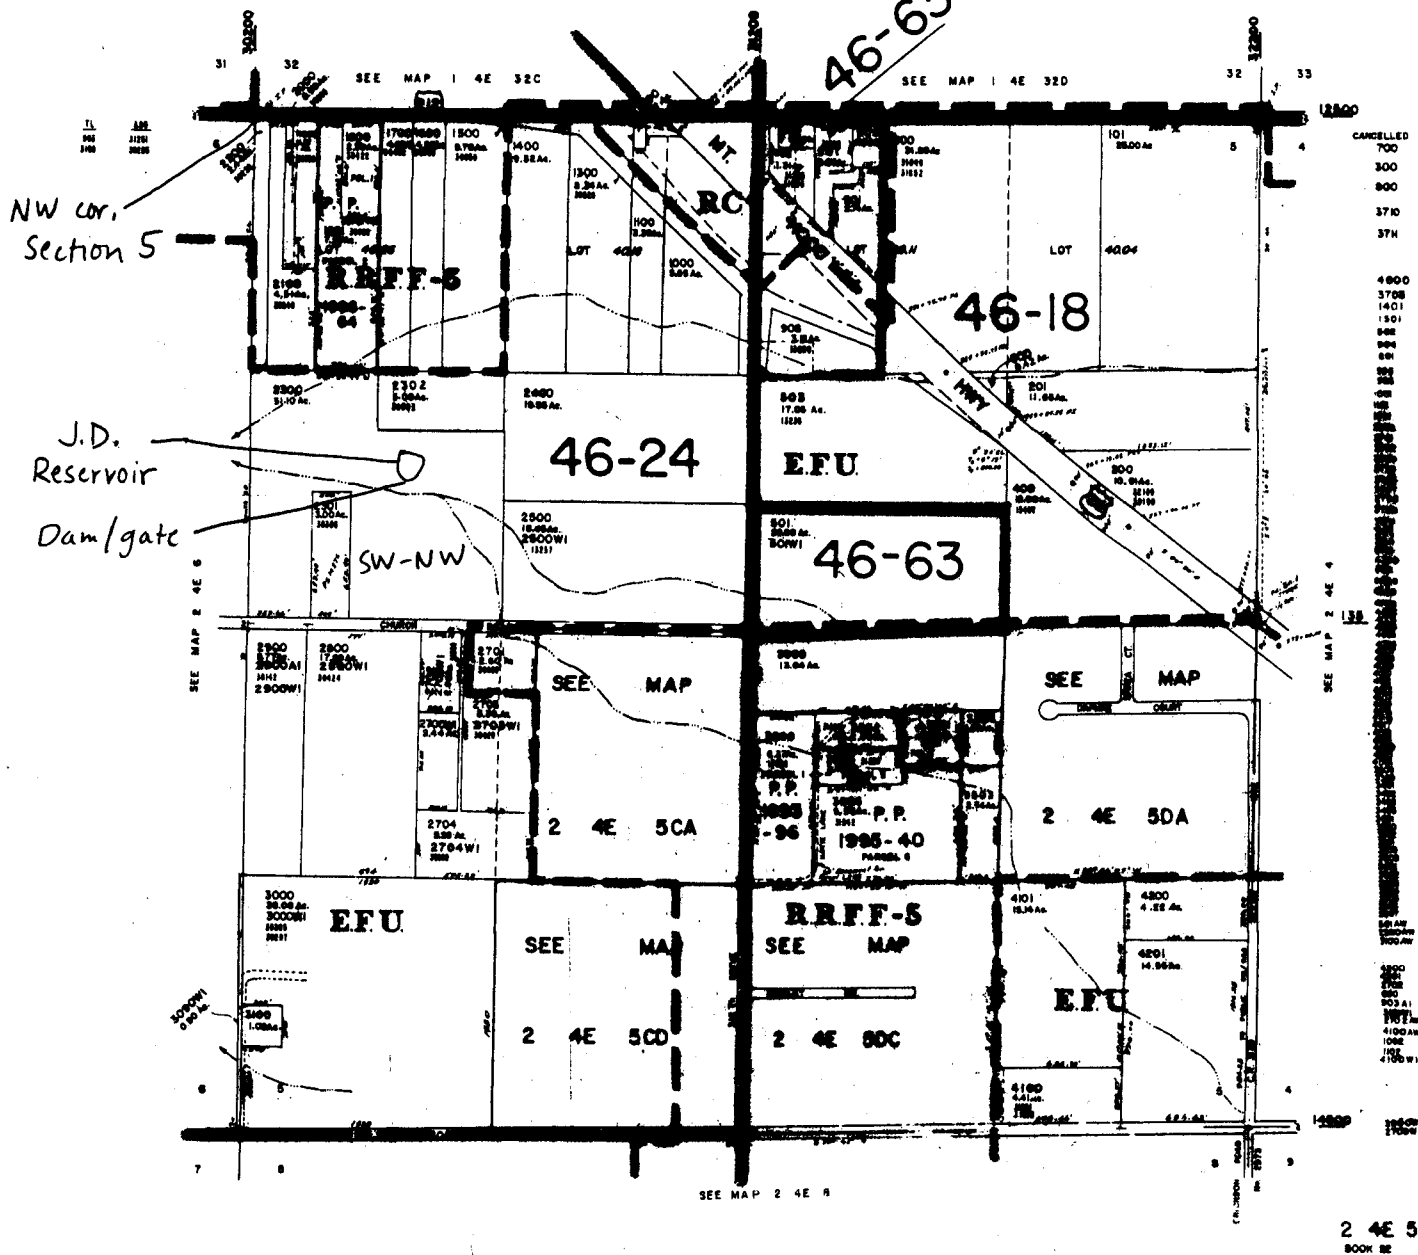

Reservoir located:  
810' E, 1800' S fr. NW corner section 5

1" = 1000'



**RECEIVED**

JAN 05 2016

WATER RESOURCES DEPT  
SALEM, OREGON

R-88163