


This map was prepared for assessment purposes only.

NW Cor.
Sec. 5

Donahue Reservoir

Dam/gate

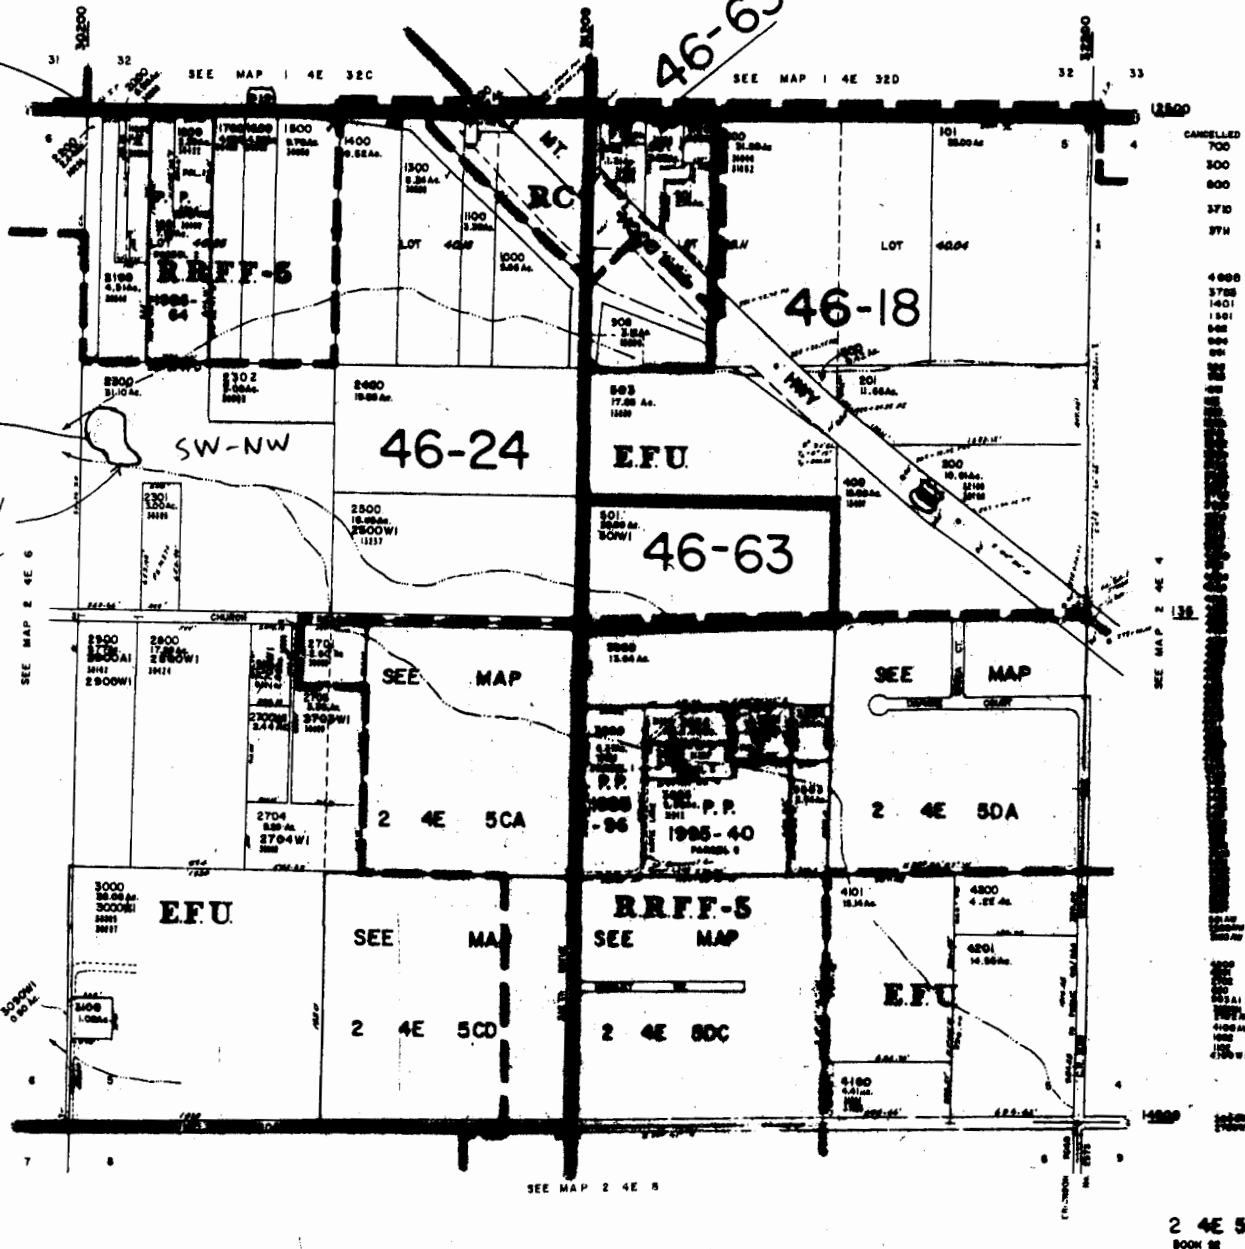

Reservoir located 150' E, 1700' S fr. NW corner section 5

1" = 1000'



RECEIVED

JAN 05 2016

WATER RESOURCES DEPT
SALEM, OREGON

R-88164