


Dan Schanz

1" = 1320'

Tax Lot:

Township 6 South, Range 4 West, Section 3, SWSE, Tax Lot 300

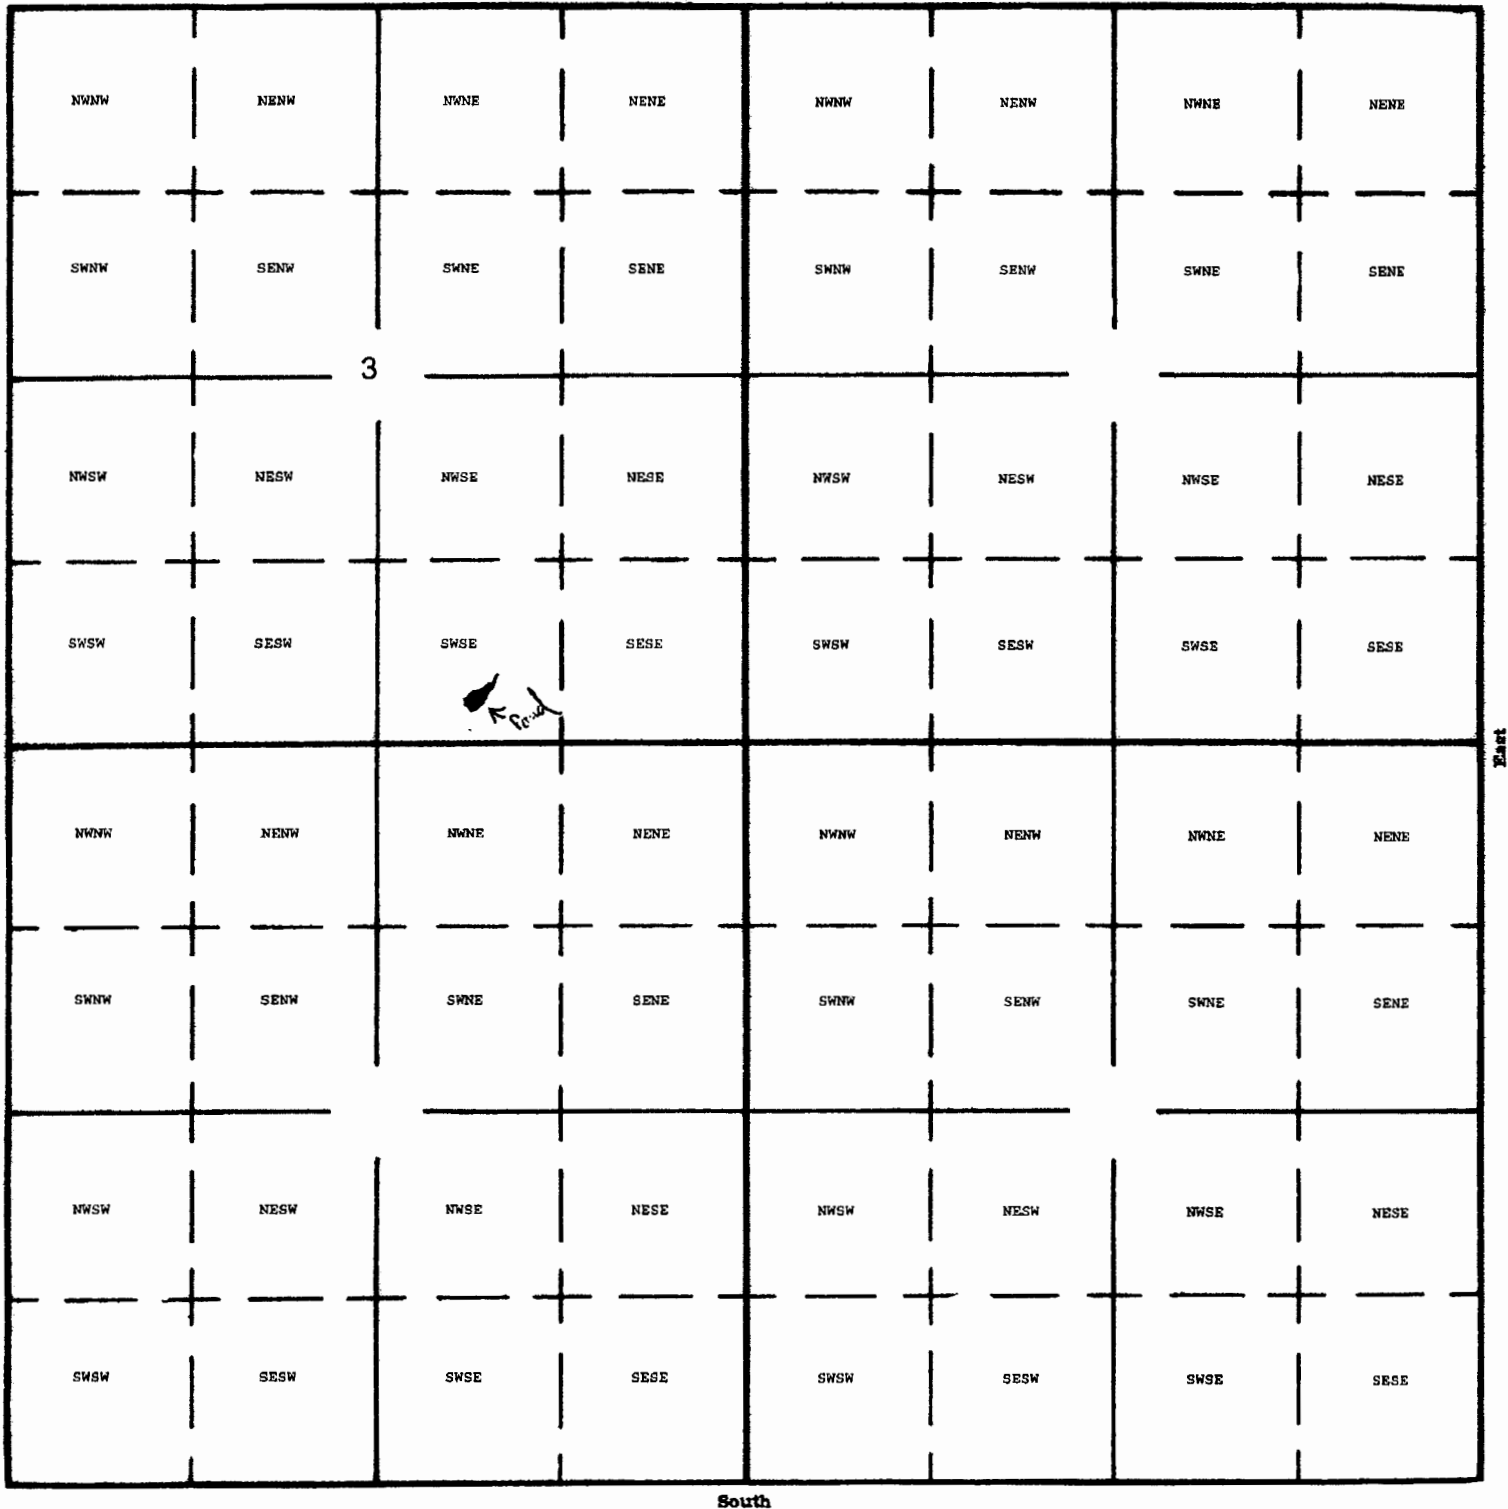

Dam Location: 270 feet north and 1960 feet west from SE Corner Section 3

**RECEIVED**

A.

APR 15 2016

WATER RESOURCES DEPT  
SALEM, OREGON

R-88209