


12-88256

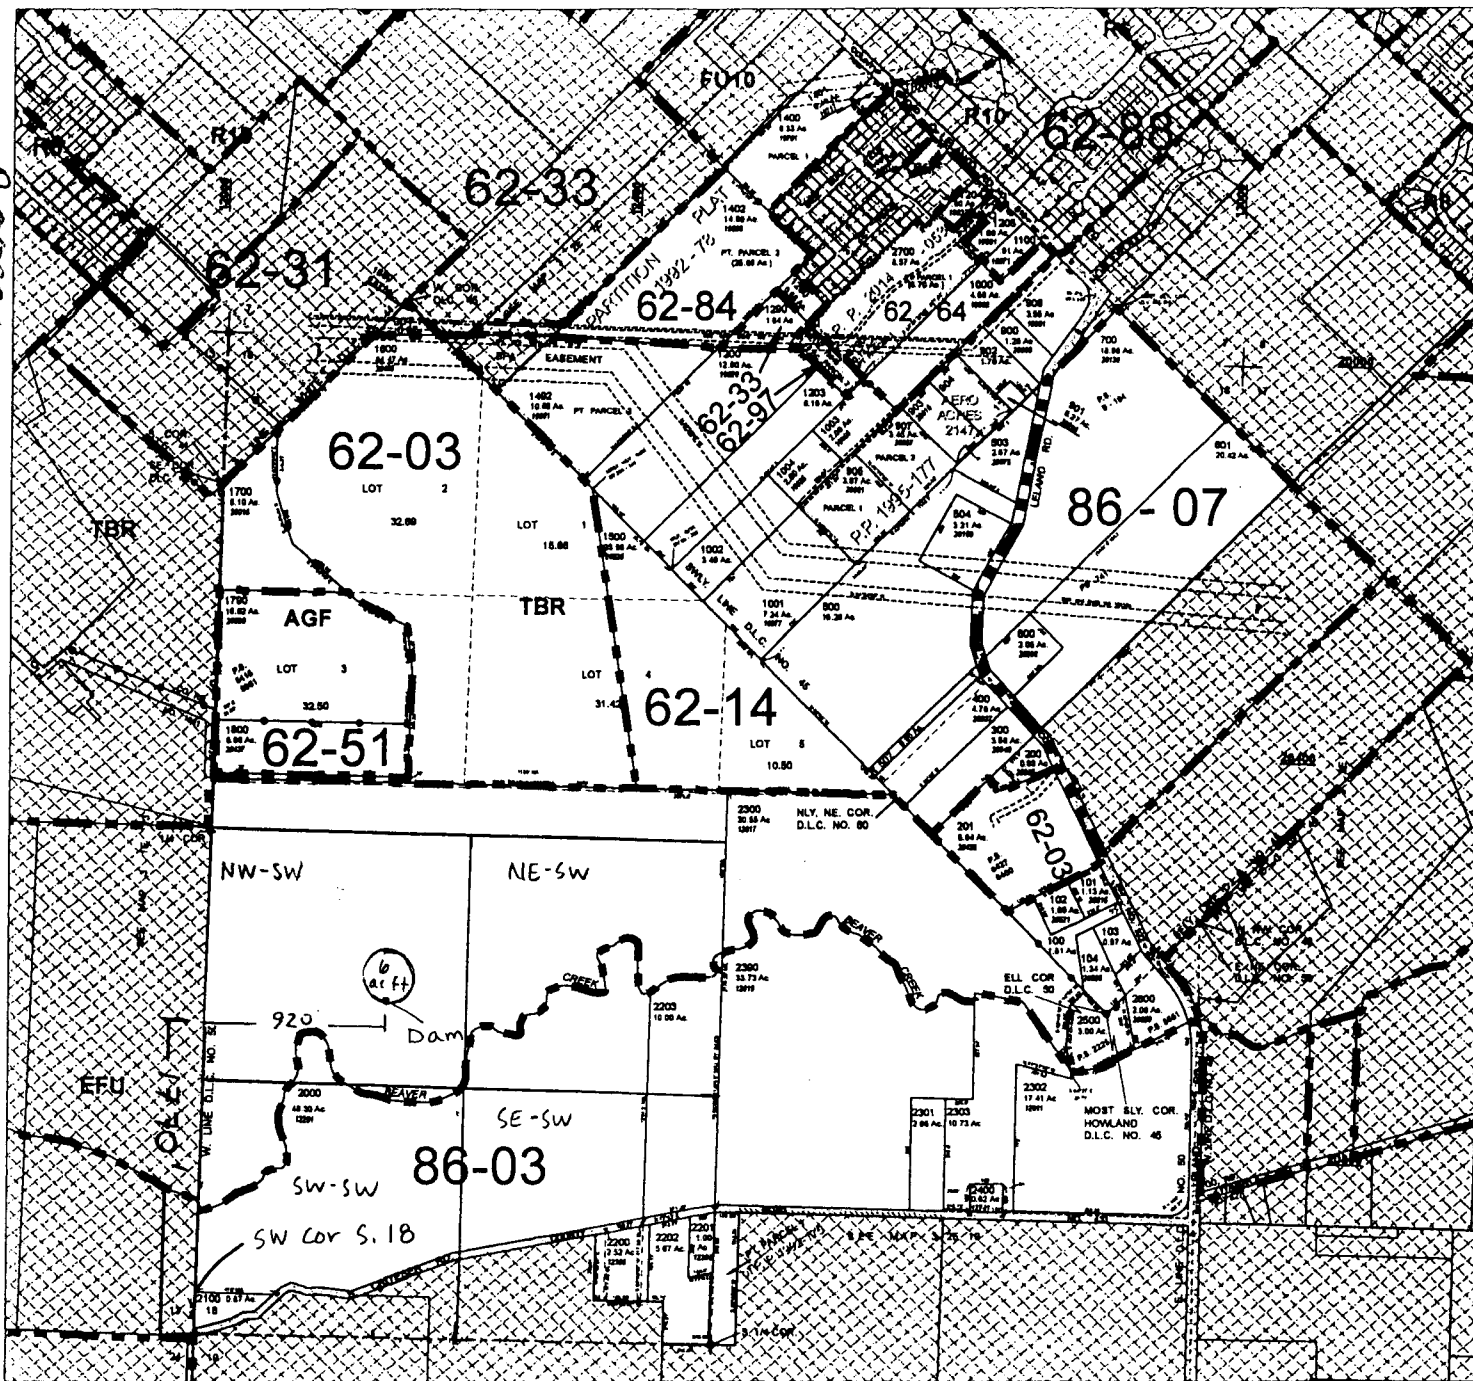

Ben McCune
 T3S, R2E
 Section 18

Scale 1"=1000'
 ↑
 N

Center of dam
 located 920' E,
 1770' N fr. SW
 Corner S. 18

RECEIVED

MAY 31 2016

WATER RESOURCES DEPT
 SALEM, OREGON