


ment  
368

75 FEET SOUTH AND 132 FEET  
EAST FROM NW CORNER, SECTION 14  
SEC.14 T9S R6W WM  
POLK COUNTY  
Scale 1" = 400'

03/29/2016 12:08 PM: f:\commercials\shf\_003

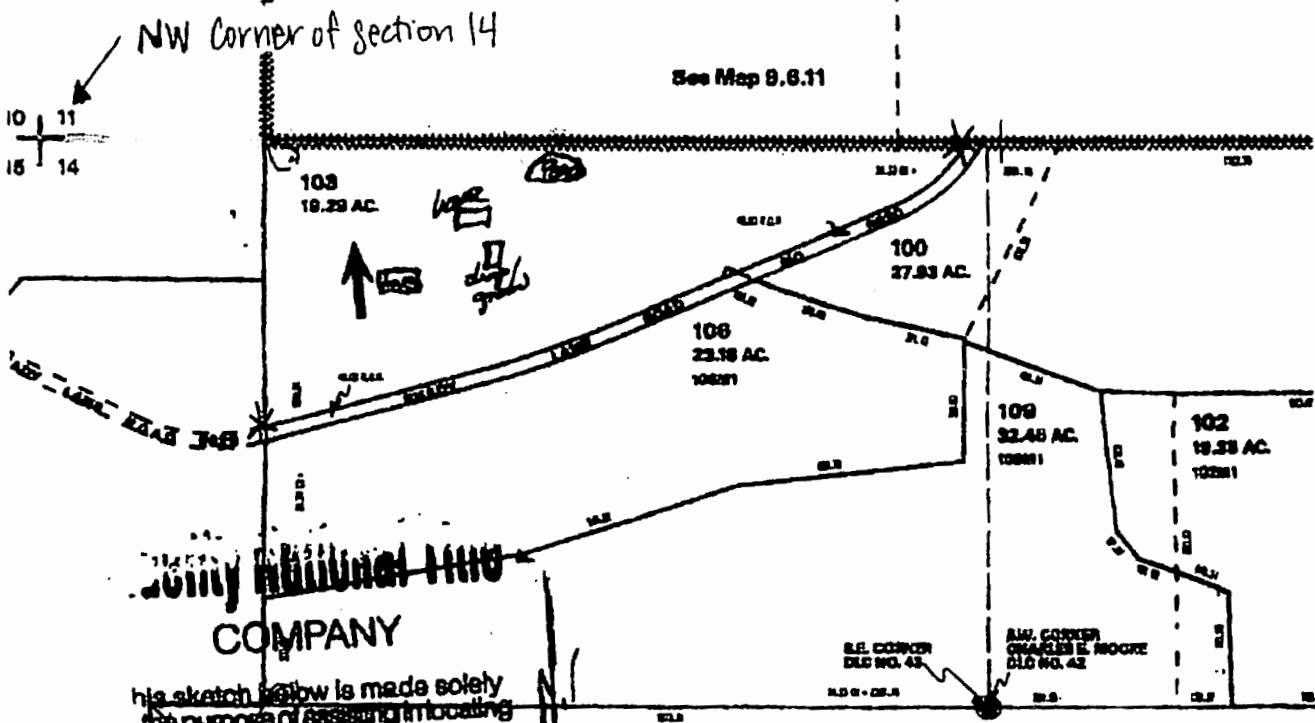

11:07 AM

03/29/2016

This sketch below is made solely for the purpose of assisting in locating the premises and the Company assumes no liability for variations, if any, in dimensions and location ascertained by actual survey.

\* PROPERTY CORNERS ON SHADY LANE ARE MARKED WITH AN ORANGE RIBBON ON FENCE.

*[Signature]*  
1/12/2017

RECEIVED

JAN 12 2017

OWRD

0-88307