


Township: 6S
Range: 6W
Section: 31


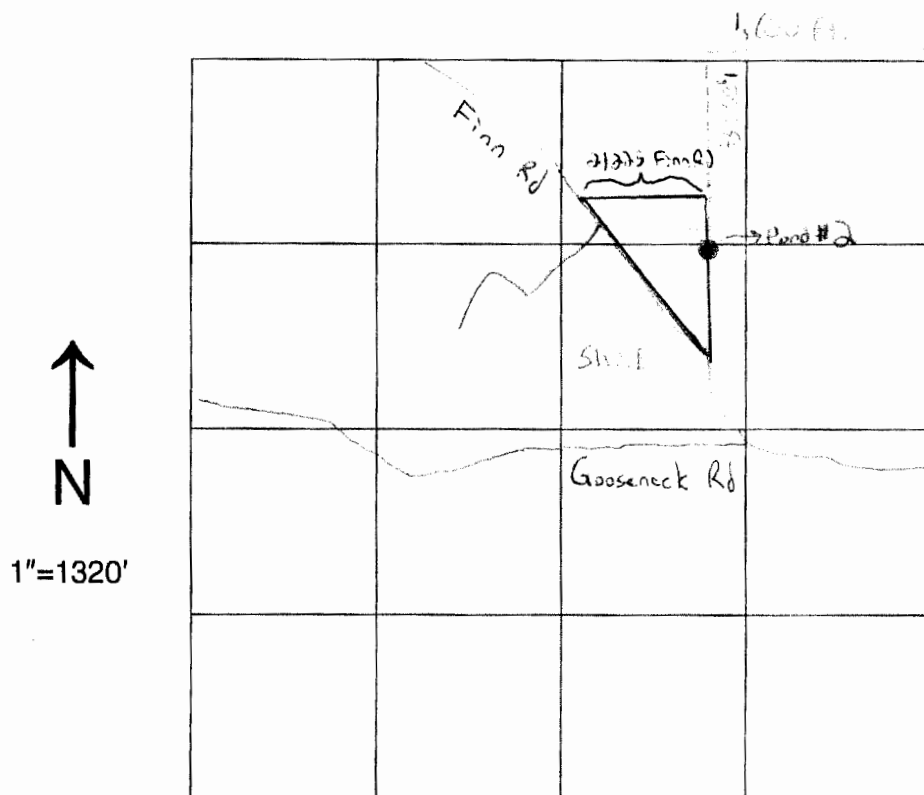


Applicant: Chris Rentzel / Agent: Ollie Collins

Application #: _____ Permit #: _____

RECEIVED
SEP 07 2016
OWRD

R-88281

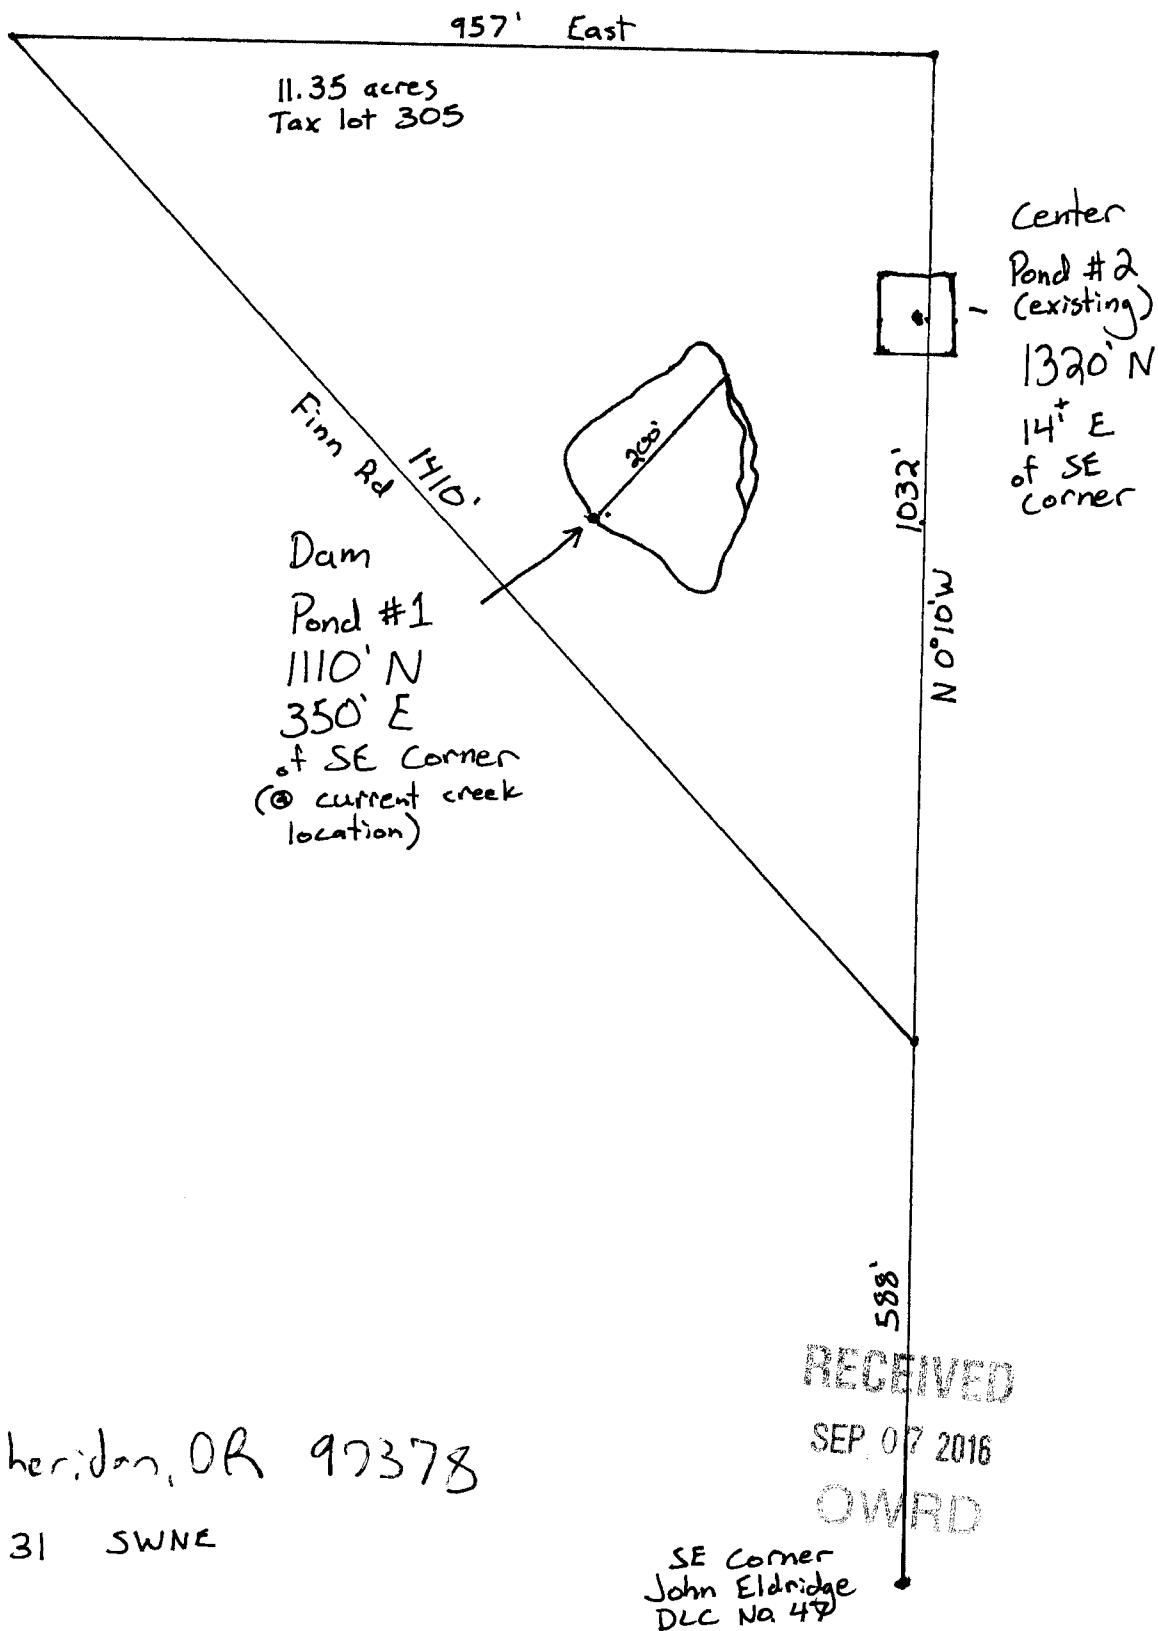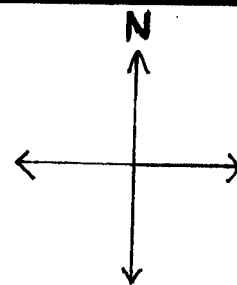

21225 Finn Rd. Sheridan, OR 97378

Location: T6S R6W Sec 31 SWNE

Scale 1" = 200'
R-88281

RECEIVED
SEP 07 2016
OWRD

SE corner
John Eldridge
DLC Na 47