


Township: 6S  
Range: 6W  
Section: 31

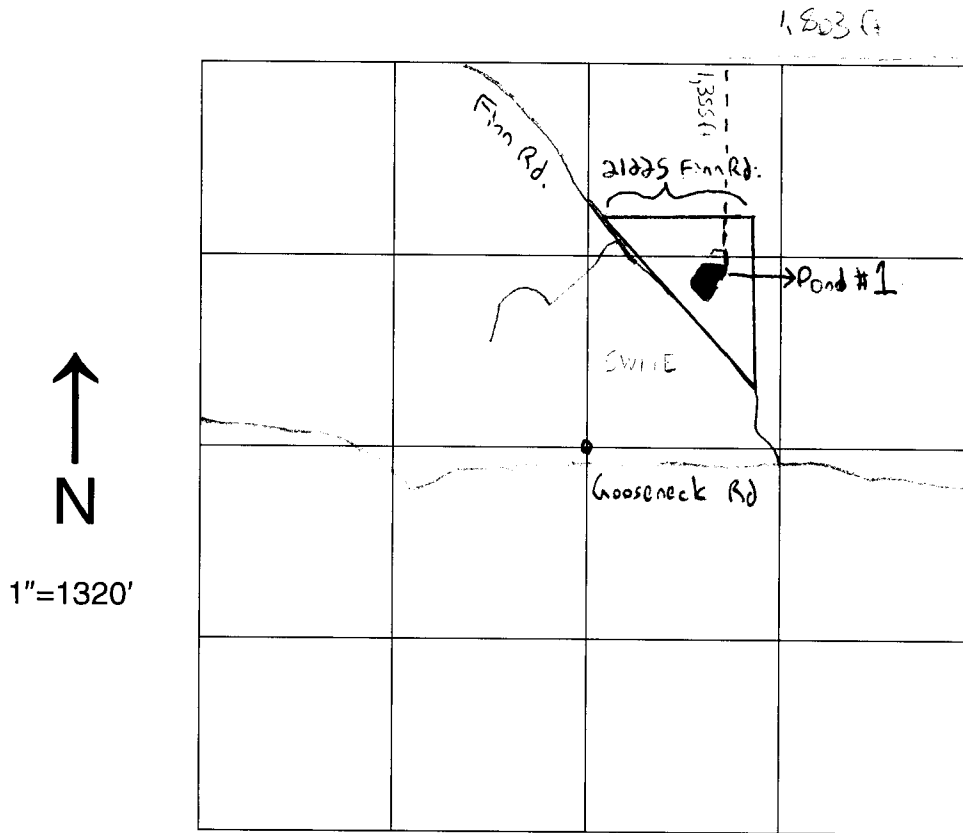

Applicant: Chris Rentzel / Agent: Ollie Collins

Application #: \_\_\_\_\_ Permit #: \_\_\_\_\_

RECEIVED

SEP 07 2016

OWRD