


Howard Schwanke

1" = 1320'

Tax Lot: 800 and 900

T7S, R5W, Sec 2

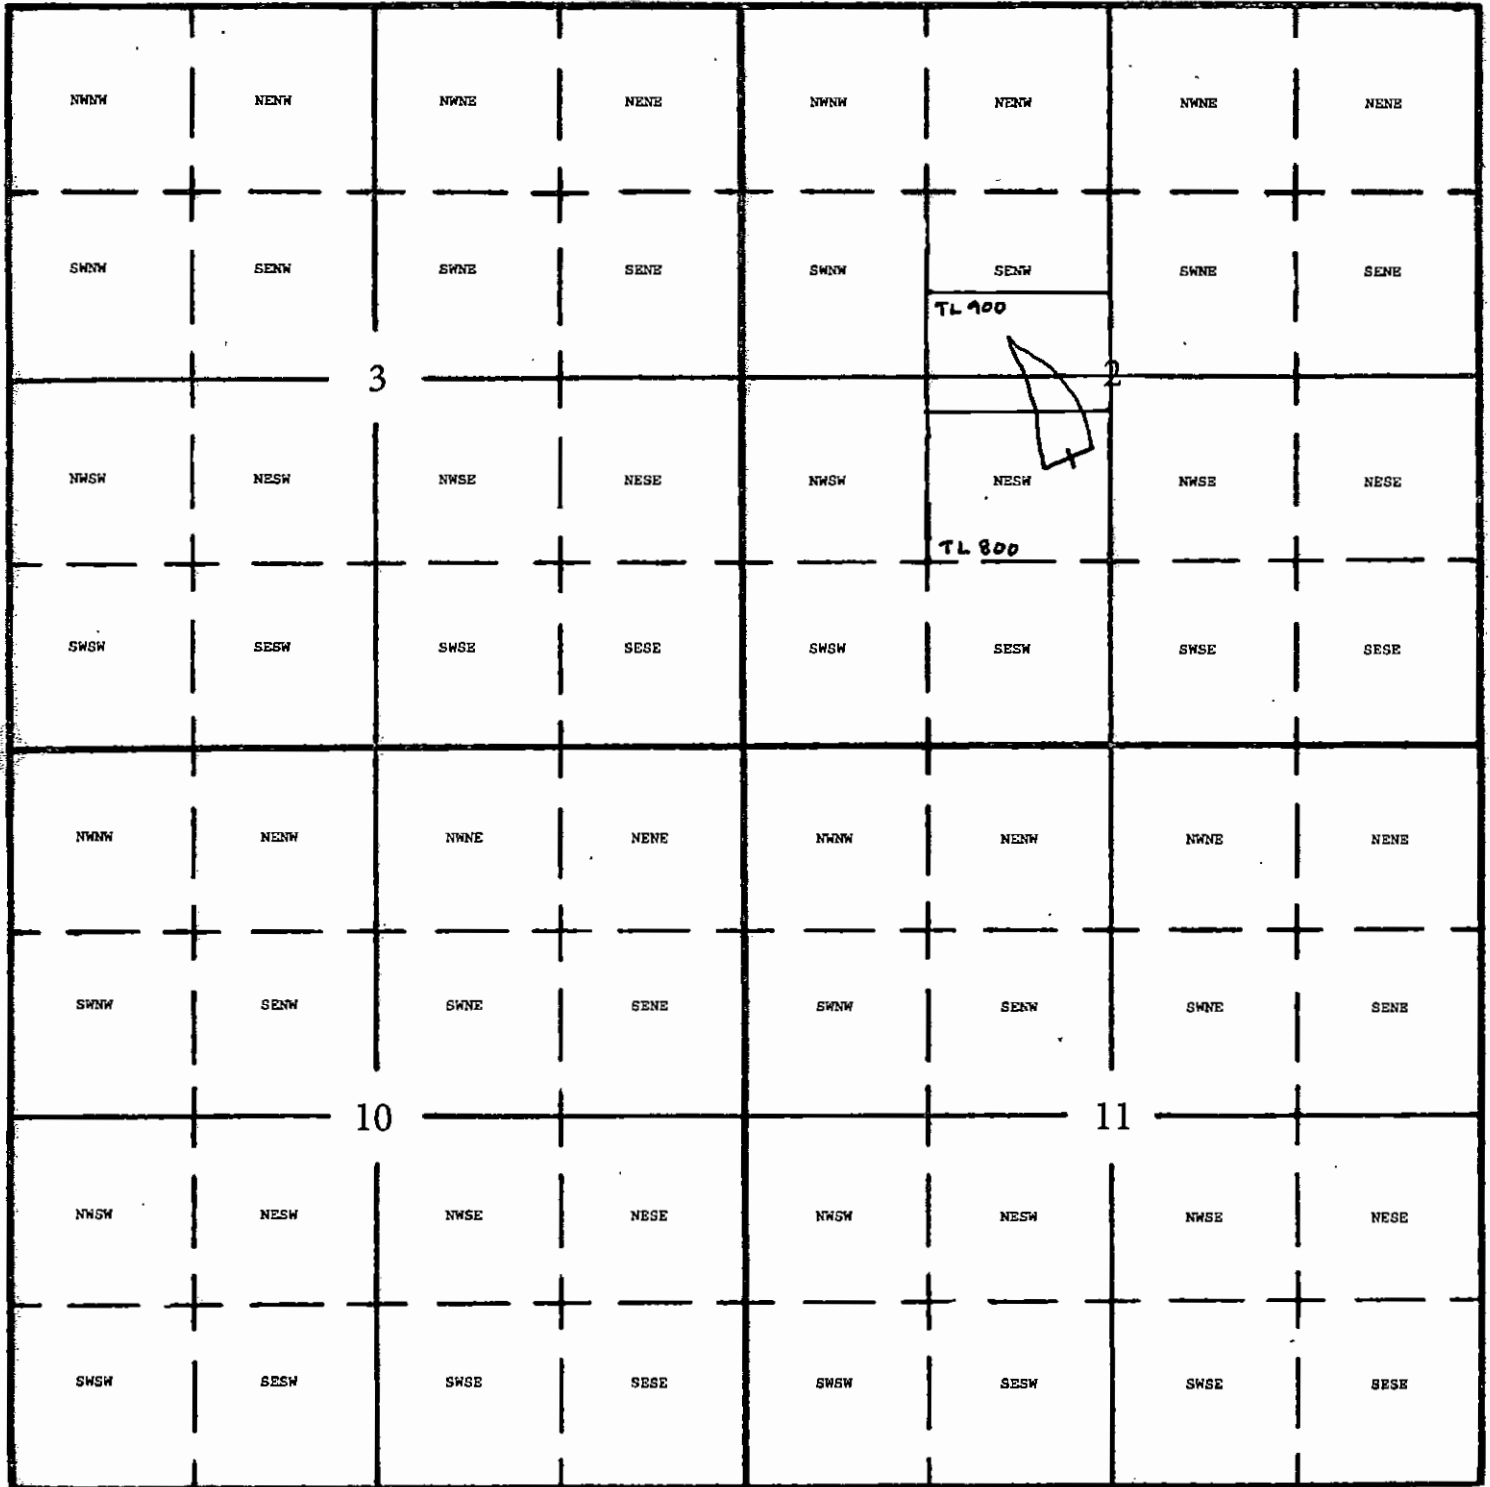

Dam center: 575 feet south & 300 feet west from C1/4 corner, Section 2

R-88300