


**IMPORTANT**  
This Map for Assessment  
and Taxation Purposes  
**ONLY**

**SEC. 2 T7S R5W WM  
POLK COUNTY**

7.5.2

Scale 1" = 400' 800'

E 1/4 N.E. CORNER  
CLAIM NO. 28  
See Map 6.5.35

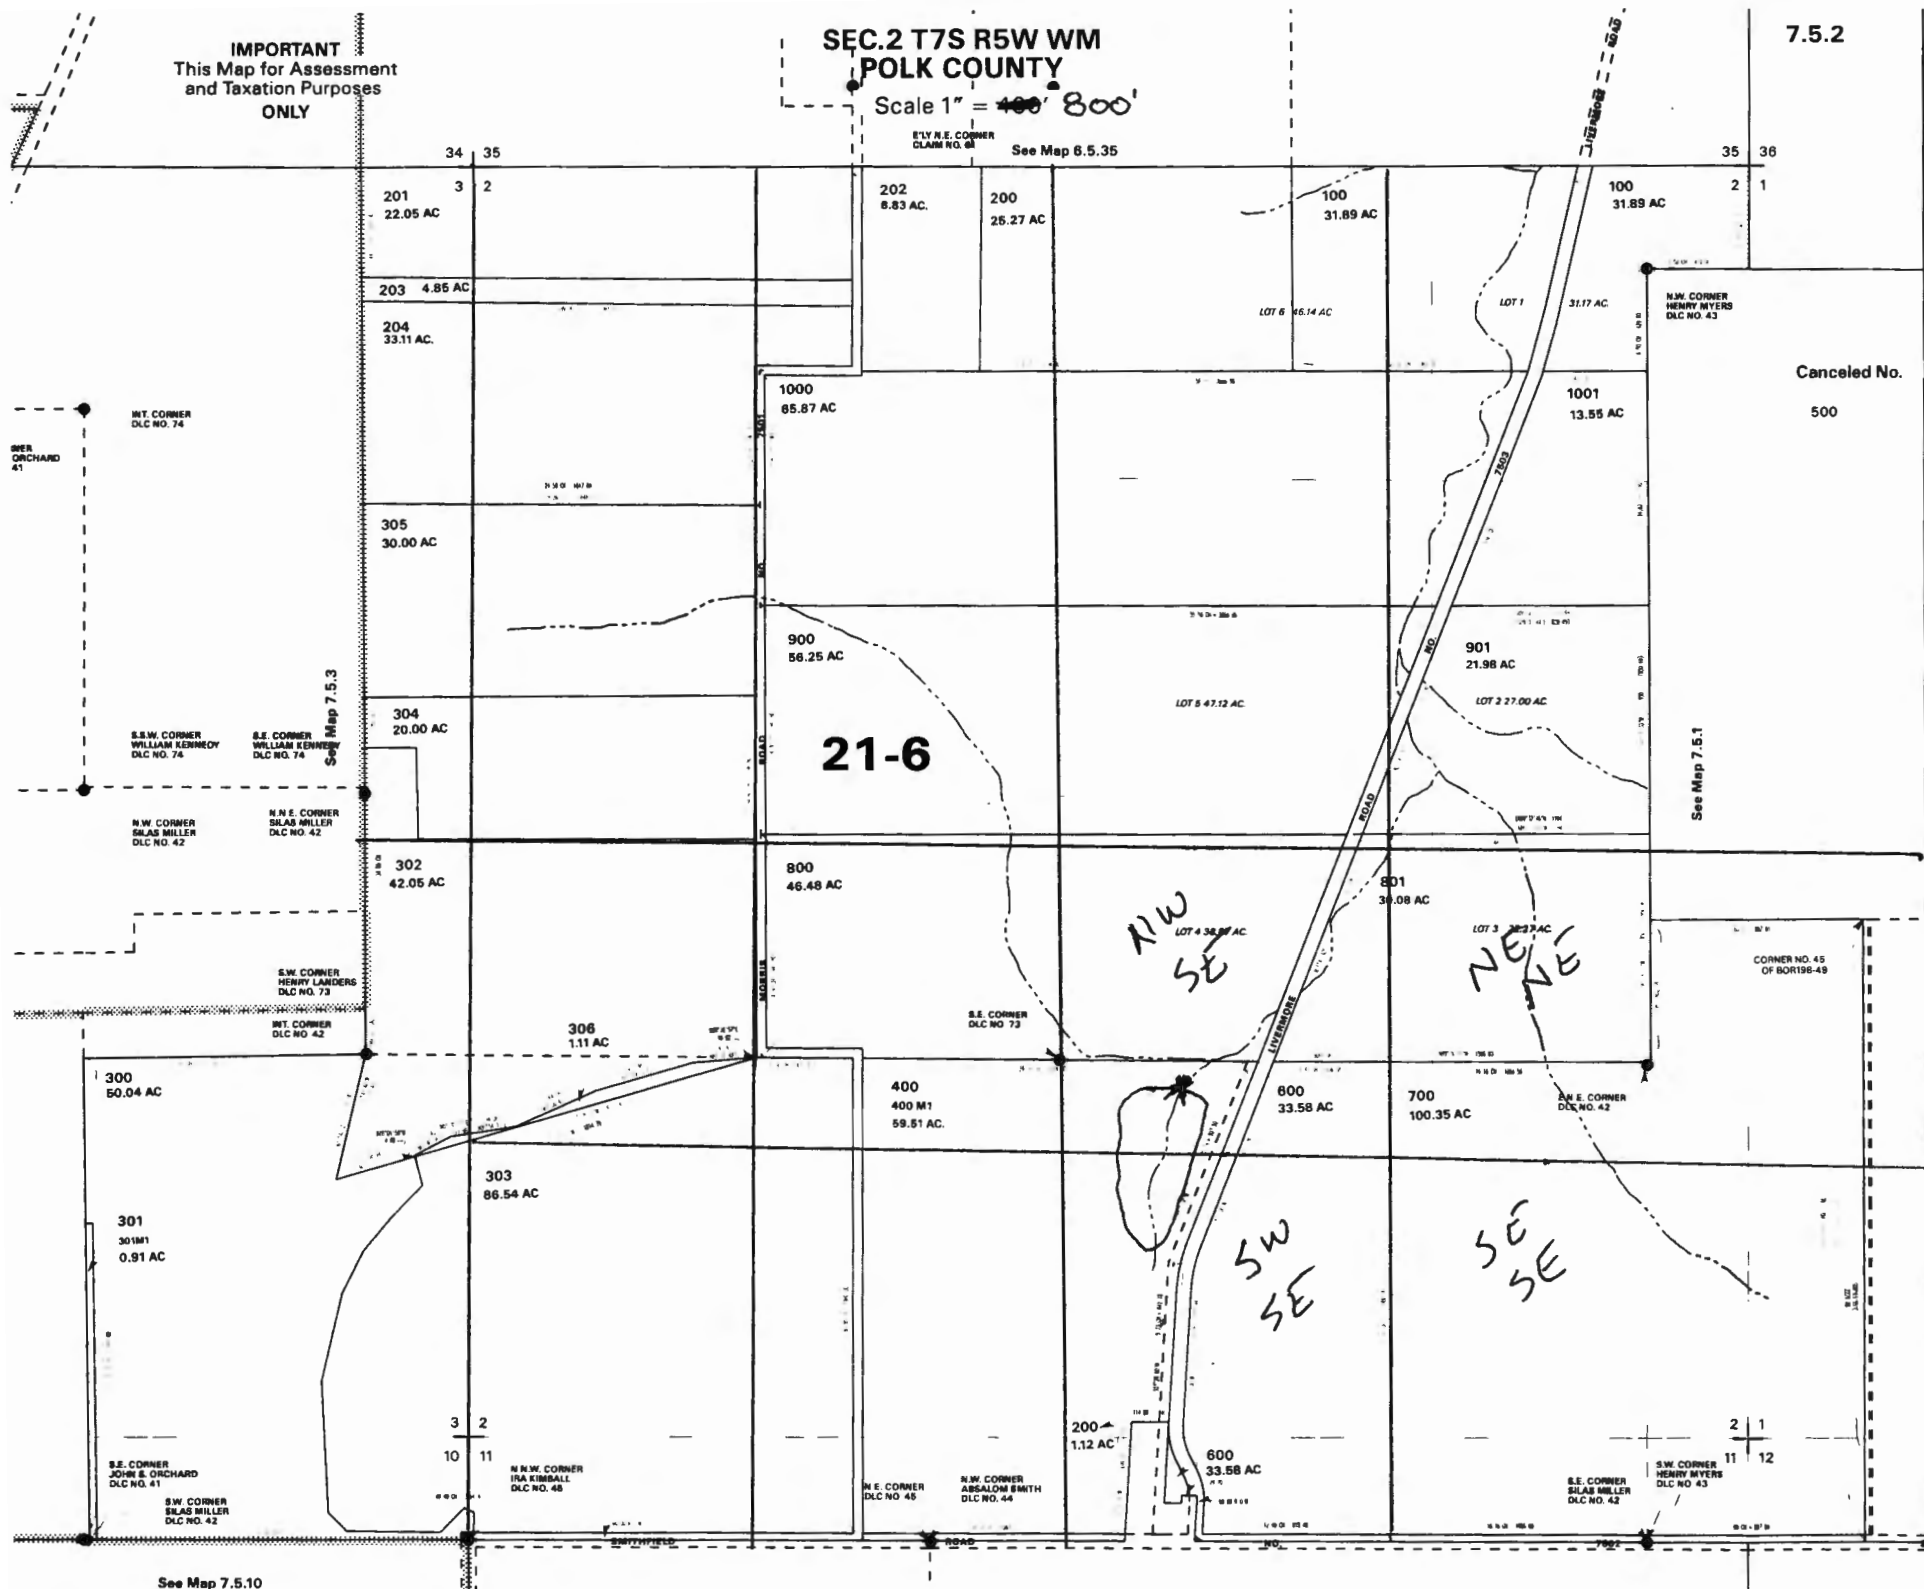

*DAMN / SPILLWAY LOCATED APPROX. 1400' N, 3000' E FROM  
SW CORNER OF SECTION 2  
R-08109*

See Map 7.5.10

See Map 7.5.11