


CATCHMENT POND 2

NORTH ↑

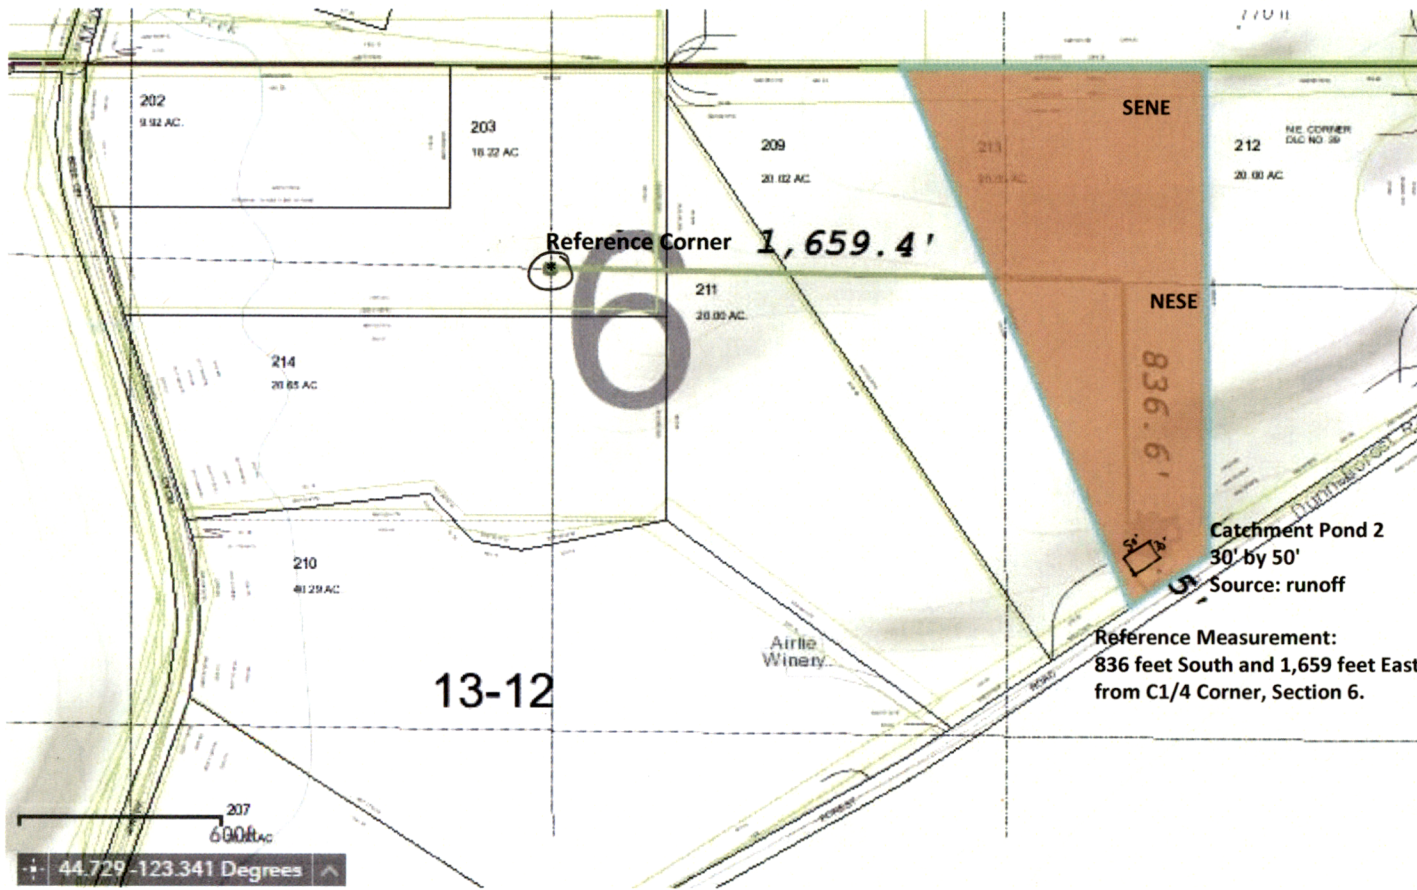

1" = 600 ft.

RECEIVED BY OWRD

APR '06 2017

SALEM, OR

2-88488