



**NOTES**

1. This map was prepared for the purpose of identifying the location of water rights only and is not intended to provide legal dimensions or locations of property ownership lines.

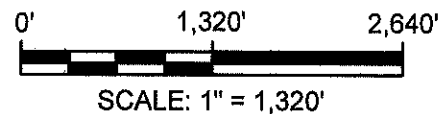


**SURFACE WATER APPLICATION MAP**  
**TAX LOT 100 & 1700**  
 Located in Section 26, 34, 35, & 36  
 T.16.S, R.23.E W.M.  
 Deschutes Basin, Crook County, Oregon

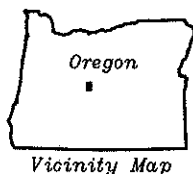

**EXPLANATION**

- Proposed Place of Use  
Total = 372.8 Ac
- 203 Tax Lot ID Number
- Tax Lot Boundary

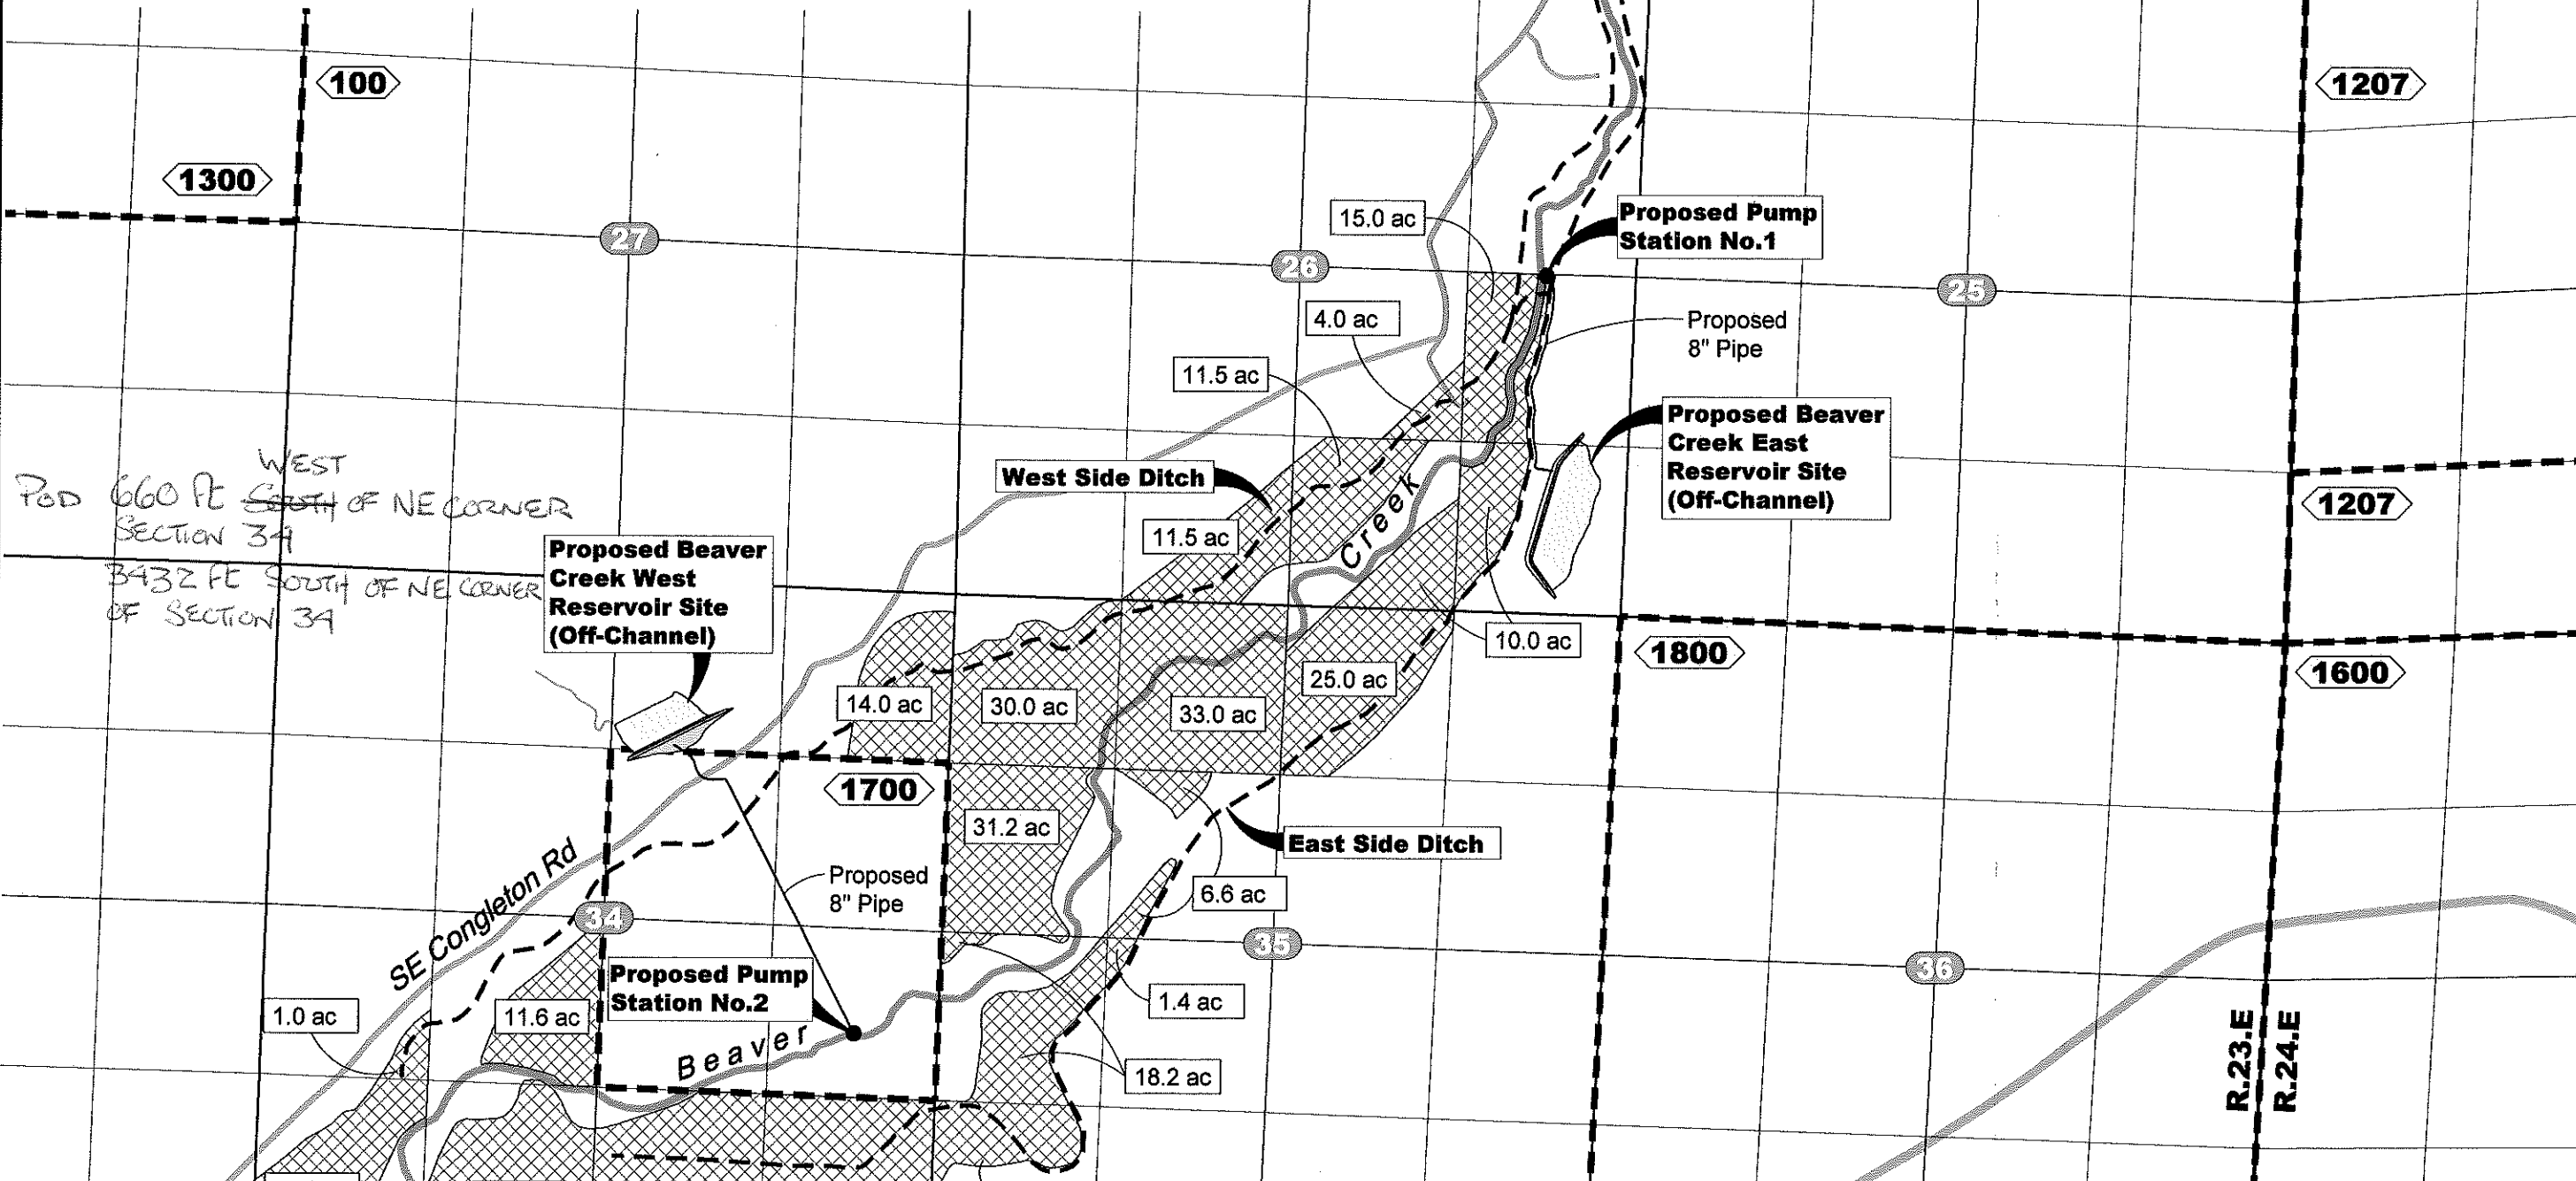

**NEWTON CONSULTANTS INC.**  
 Earth, Water and Rock Specialists  
 Ph: 541 504-9960 Fax: 541 504-9961

Storage Right Application Map  
 Beaver Creek East & West Reservoir  
 Blue Mountain Ranch  
 Deschutes Basin, Crook County, Oregon

DESIGNED BY: M.Perle	DRAWN BY: S.Schenck	DATE: June 2007	PROJECT NO. 1050-103	FIGURE 1
-------------------------	------------------------	--------------------	-------------------------	-------------

RECEIVED  
 JUN 29 2007  
 SALEM, OREGON

appno R 86935