


Teeney Pond Water Right Map

1" = 1320'

Tax Lot:

Township 6 South, Range 1 East, Section 17, Tax Lot 1800 & 500

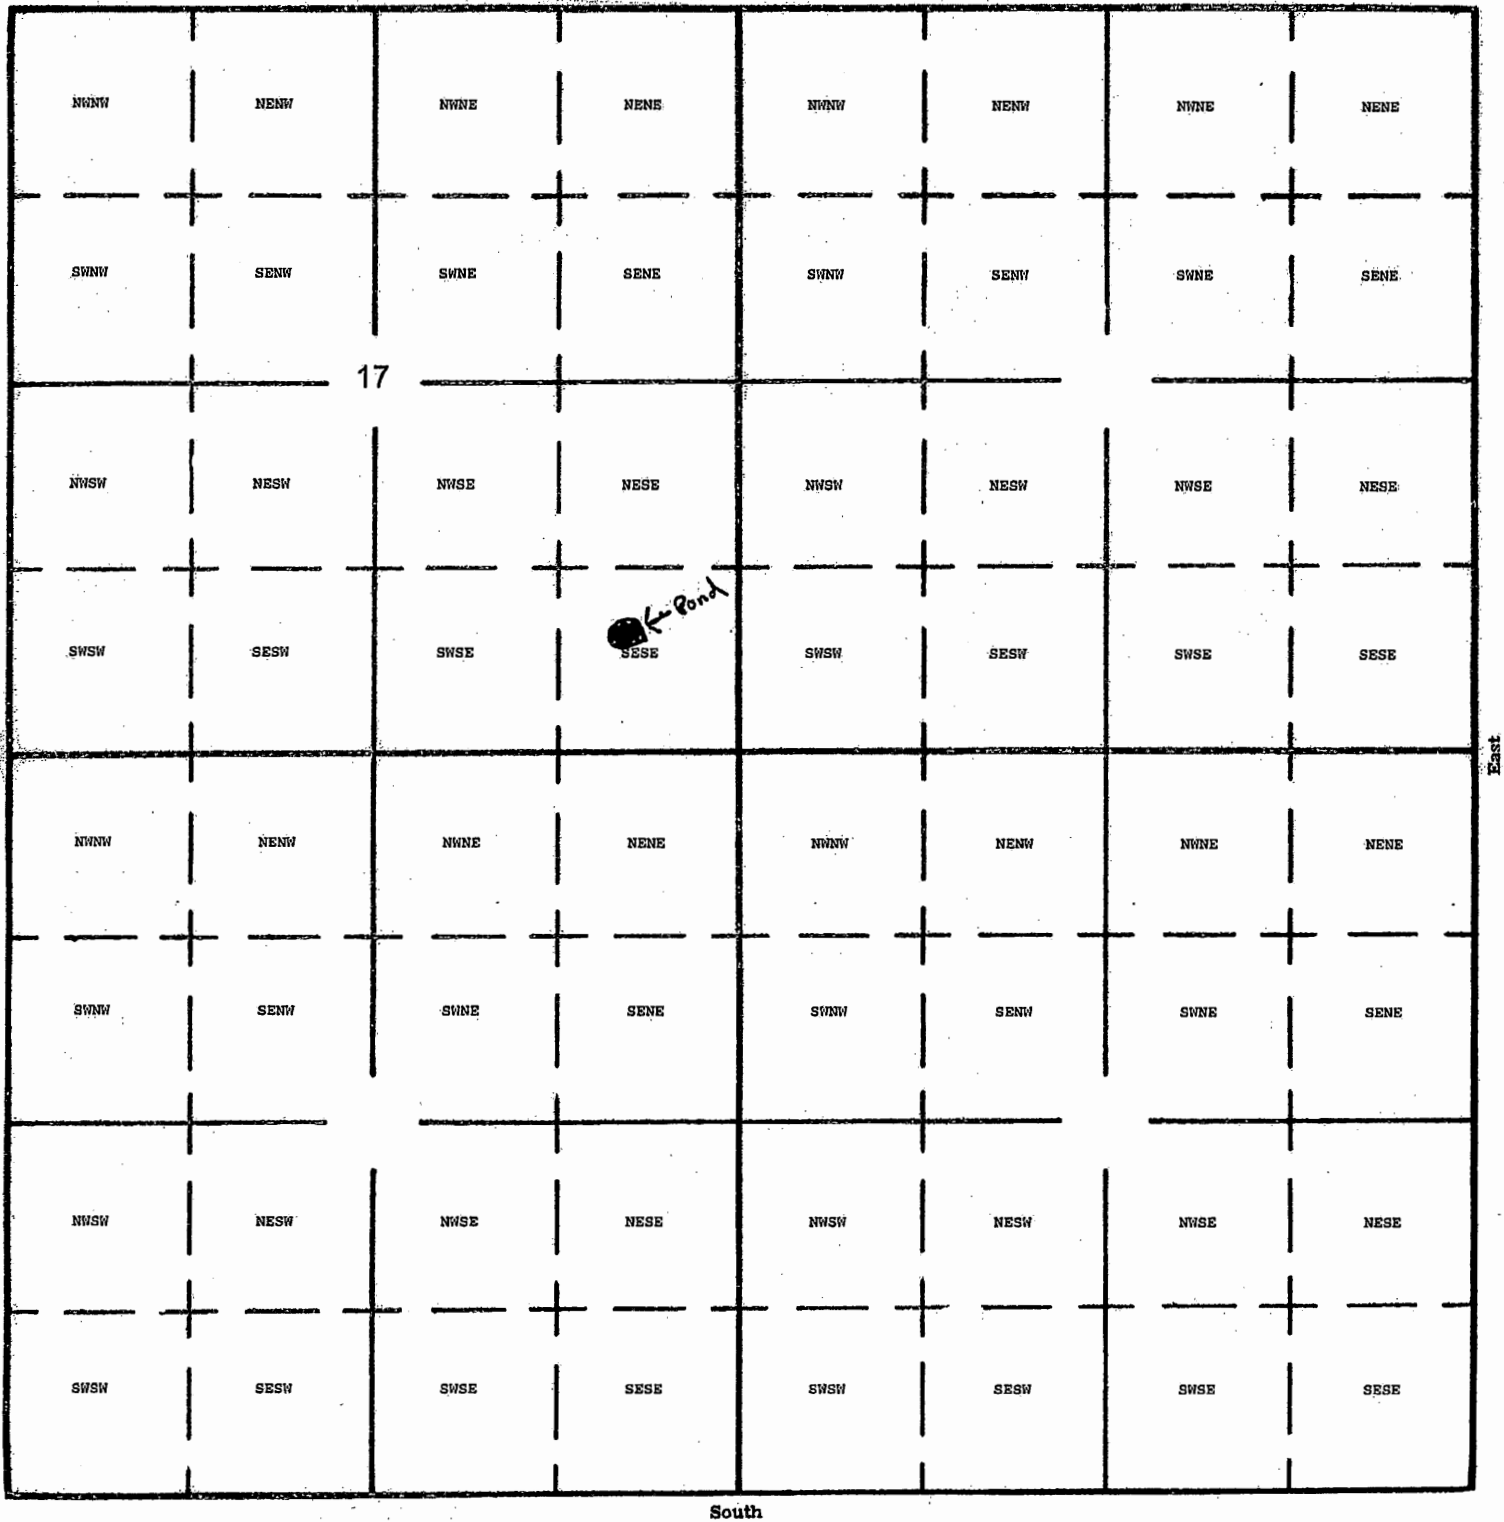

Dam Location: 850 North and 720 West from SE Corner Section 17

*Hay Stapp* 5-17-2017

RECEIVED BY OWRD

JUN 12 2017

SALEM, OR

R-88416