


# T37S R5W Northwest Quarter Section 18

Northwest corner Section 18

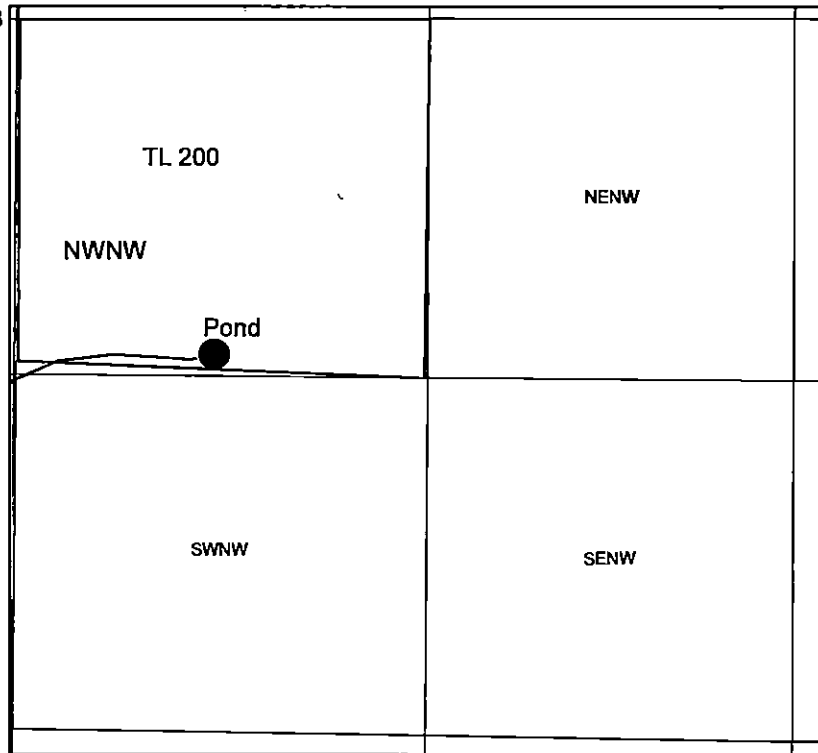

1 inch = 660 feet

The pond is located 740 ft east and 1233 ft south from the northwest corner of Section 18.

RECEIVED BY OWRD

MAY 05 2017

SALEM, OR

R-88405



NENE

NWNW

NENW

NWNE

NENE

NWNW

SENE

SWNW

SENW

SWNE

SENE

SWNW

37 S 6 W

18

NESE

NWSW

NESW

NWSE

NESE

NWSW

RECEIVED BY OWRD

MAY 05 2017

SALEM, OR

SESE

SWSW

SESW

SWSE

SESE

SWSW

37 S 5 W

288405