


Pond Application Map
Richard Rush
Section 32 T.24S. R.7W.
Douglas County
Scale = 1" = 400 ft.

RECEIVED BY OWRD

OCT 16 2017

SALEM, OR

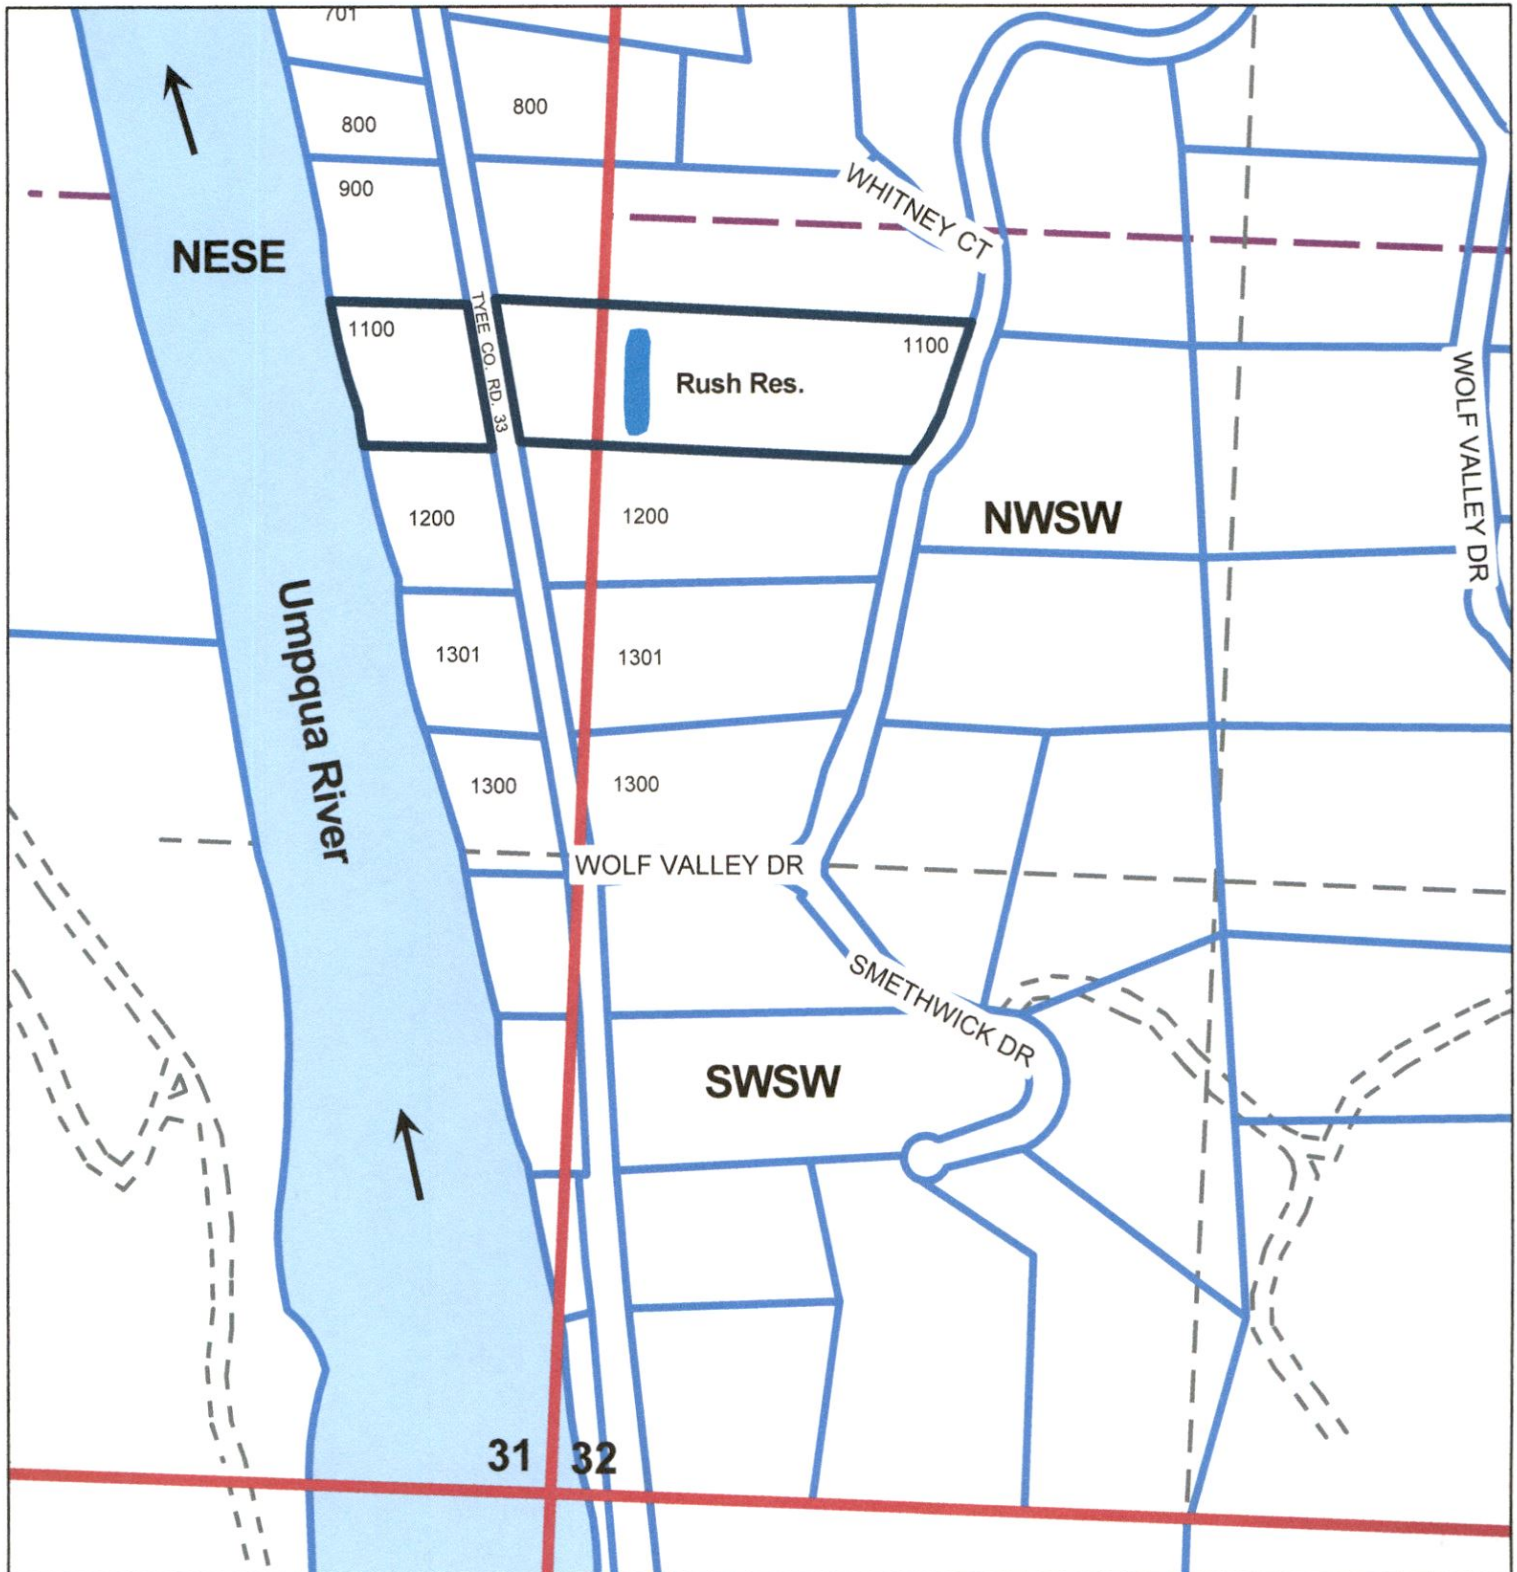

Pond is located 2330 ft. North and 75 ft. East from the Southwest Corner of Section 32

R-8846s