


Michelle Woods 3/29/2016

Michelle Woods
1" = 1320'

Tax Lot:



Township 8 South, Range 1 West, Section 27, NWNW, Tax Lot 600

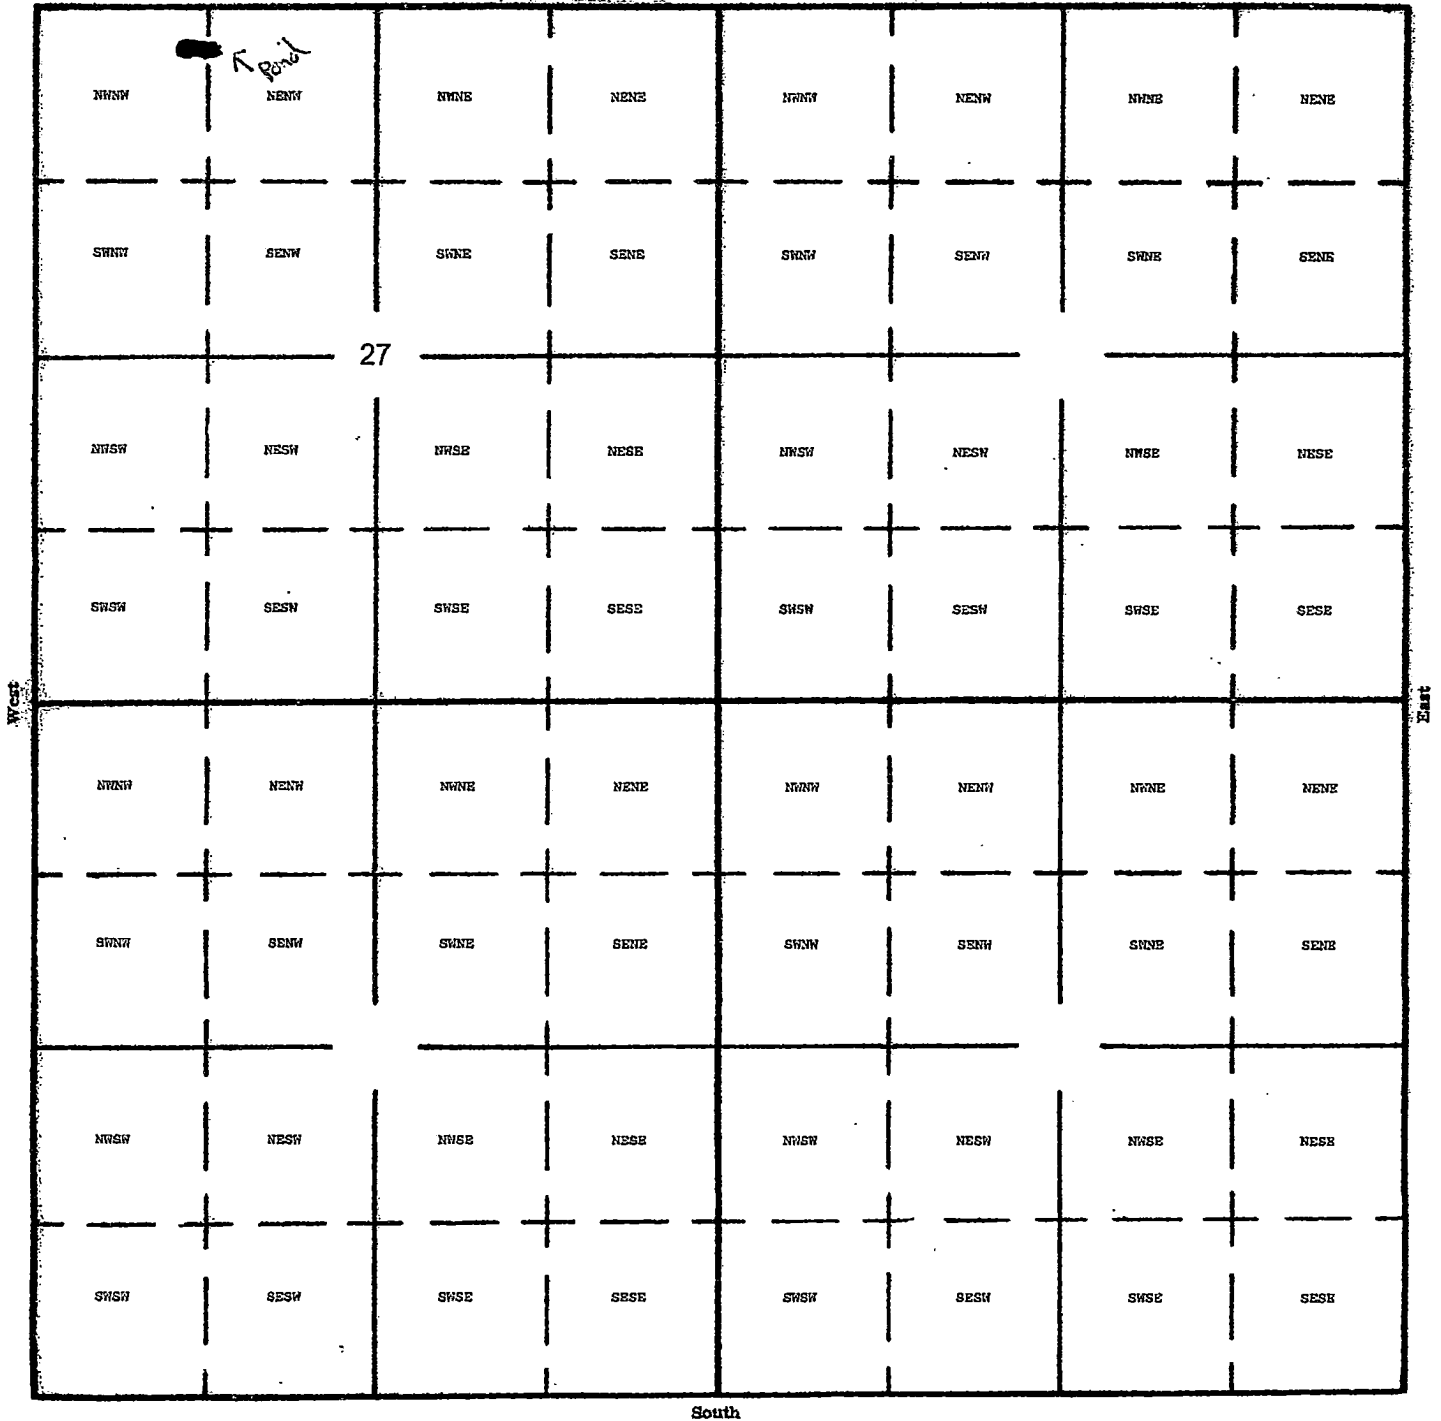

Dam Location: 1260 feet east and 330 feet south from the NW corner Section 27

RECEIVED BY OWRD

RECEIVED BY OWRD

JUN 06 2016

DEC 18 2017

SALEM, OR

R-88484

SALEM, OR