
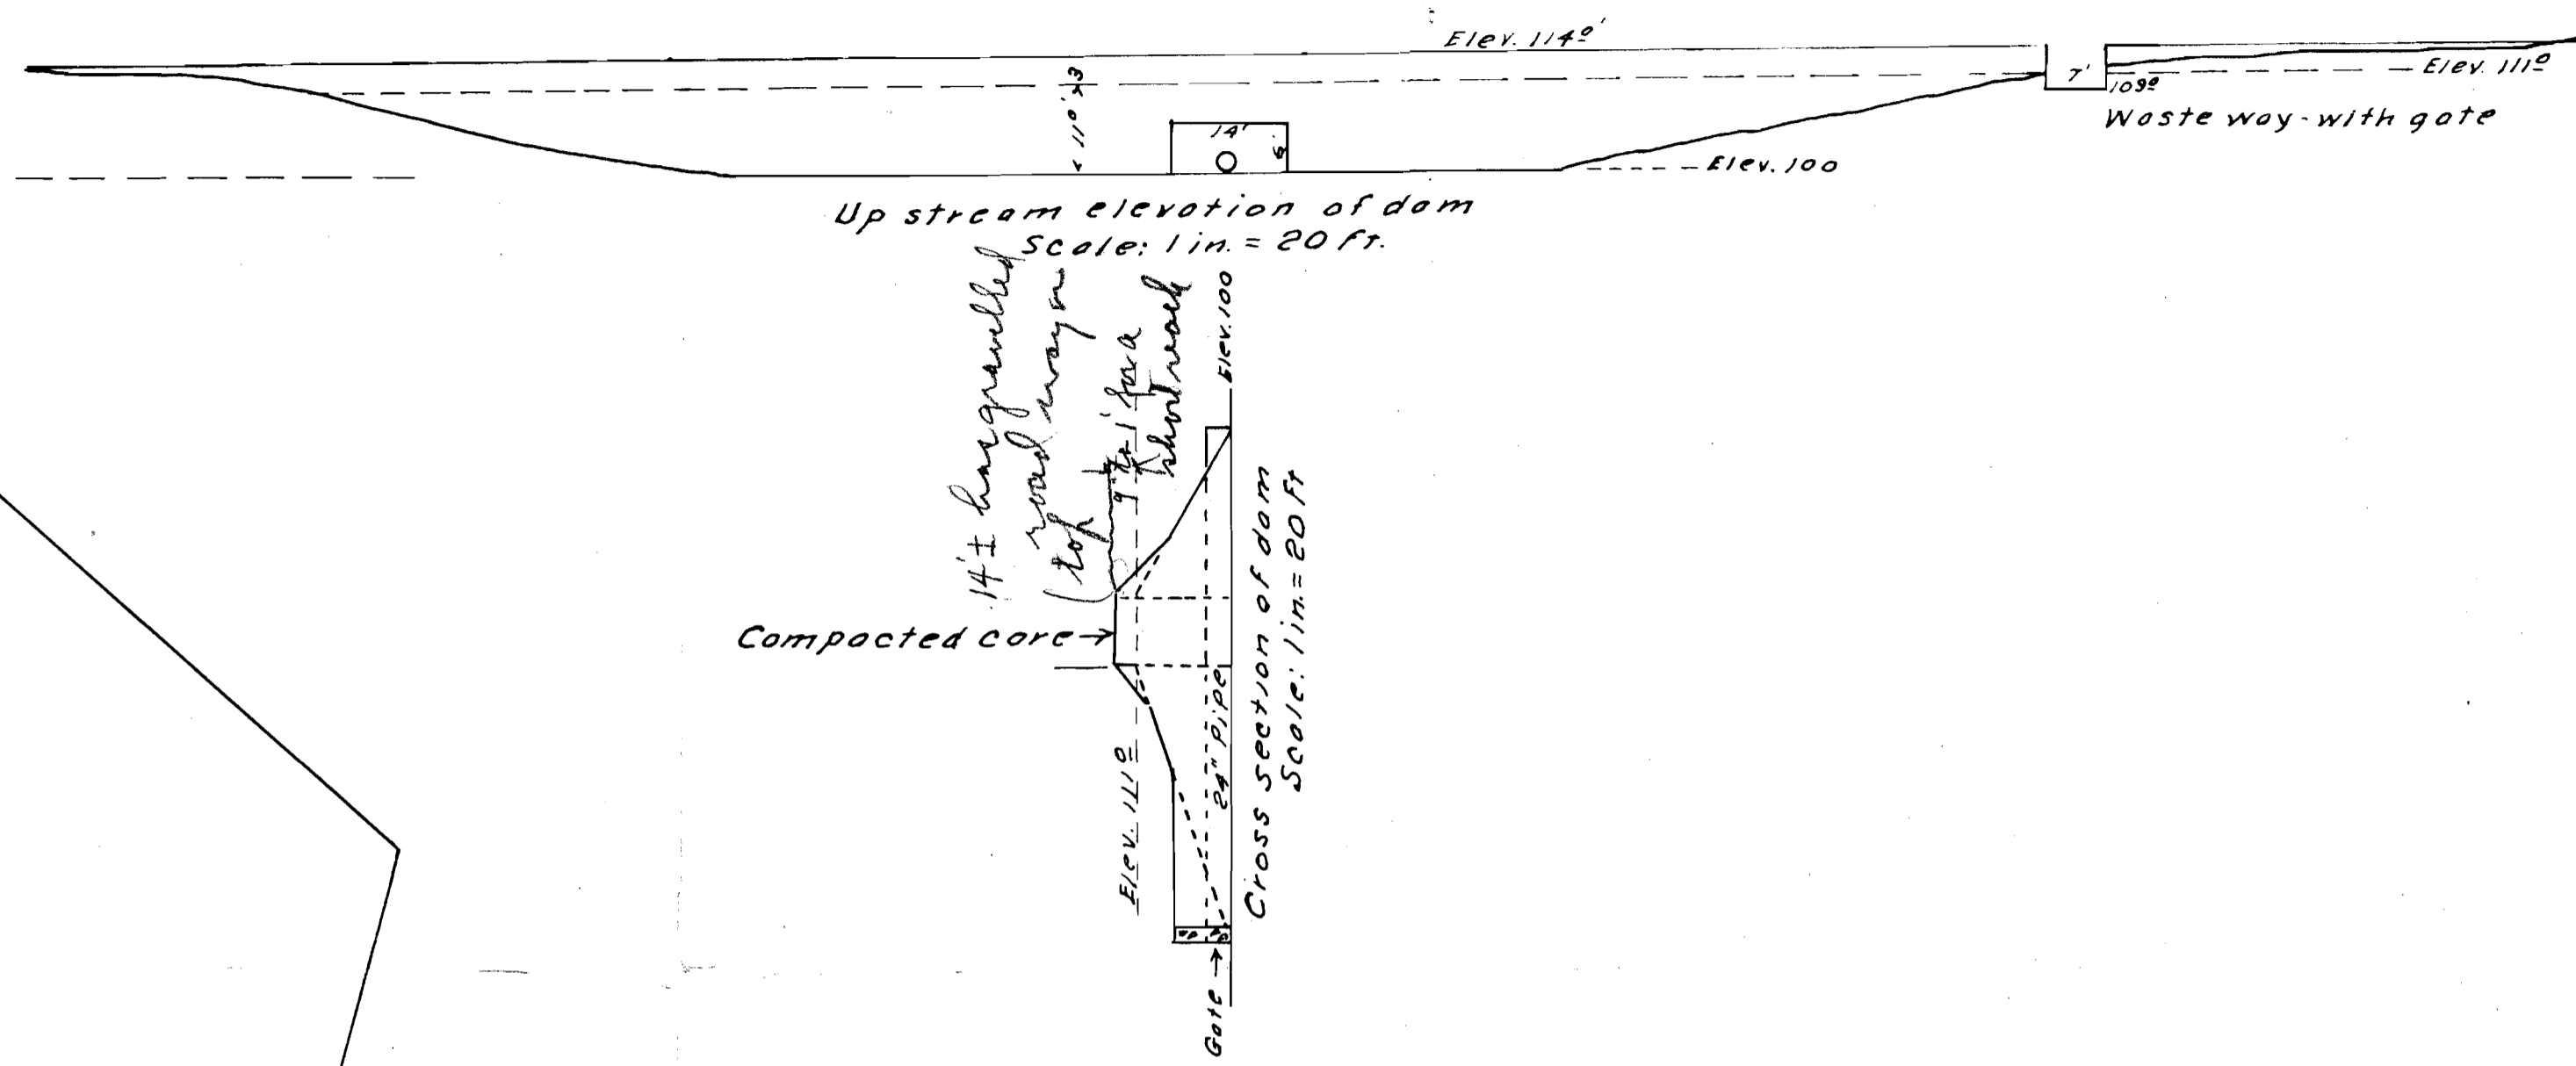


Scale: 1 in = 100 ft.

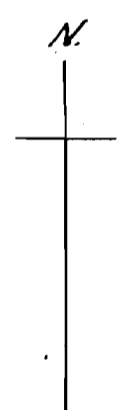

Map accompanying application of
 Western States Plywood Cooperative
 to appropriate water
 and to construct a reservoir.

I, J. N. Gearhart, of Myrtle Point, Oregon, do hereby certify that this map was made from notes taken during an actual survey made under my direction on Sept 17, 1951, and that it correctly represents the works described in the accompanying application together with the location streams in the immediate vicinity. J. N. Gearhart
 Oregon No. 183.

Application No. R 26495
 Permit No. 26496

RECEIVED
 1951
 STATE ENGINEER
 OREGON