


WORKING COPY

T9S, R1E, WM
MARION COUNTY

RECEIVED
MAY 20 2002
WATER RESOURCES DEPT
SALEM, OR

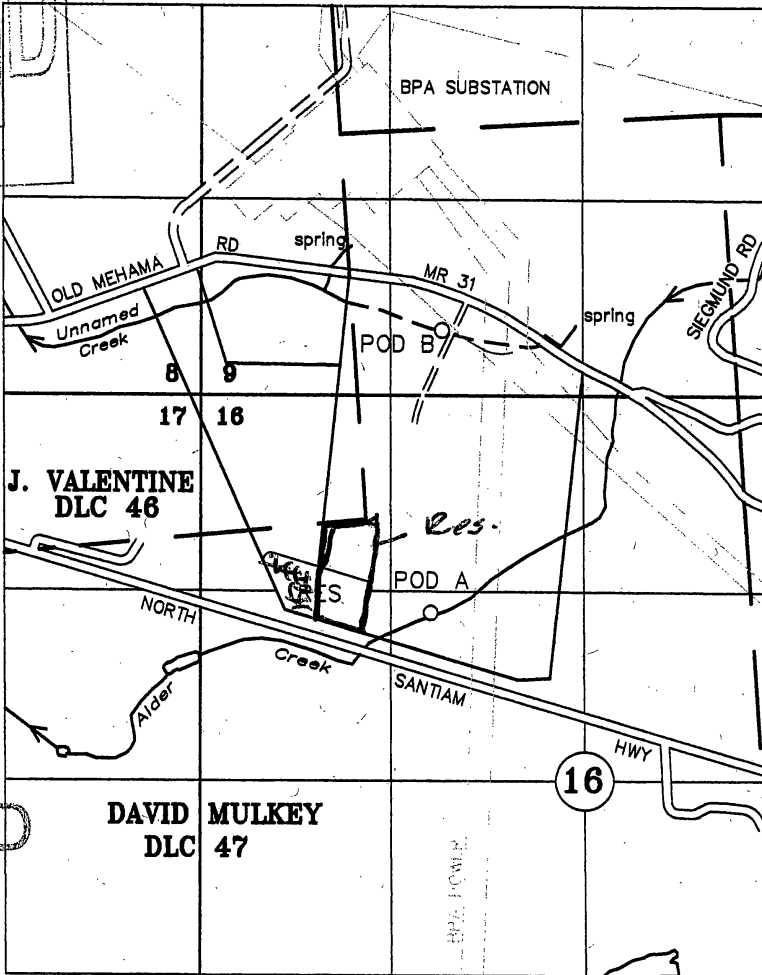

--- SURFACE WATER
IN UNDERGROUND
PIPE

TAX LOT:
9 1E 16 00100
9 1E 16B 00200

RECEIVED

932

DEC 27 2017

OWRD

POD A - 1595' E and 1510' S of the NW cor Section 16

POD B - 1670' E and 445' N of the NW cor Section 16

RESERVOIR - 800' E and 1300' S of the NW cor Section 16

APPLICATION TO STORE SURFACE WATER
UNDER

18921
0

14531
14904

14312
14904

Application No. _____ Permit No. _____ Certificate No. _____


Application No. *R-85179*

Permit No. *R-13482*

DANIEL L. HAFNER
WALTER F. HAFNER
KIMSEY PLACE, LLC
(GERALD M. HAFNER)

APRIL 15, 2002

SCALE: 1" = 1320'

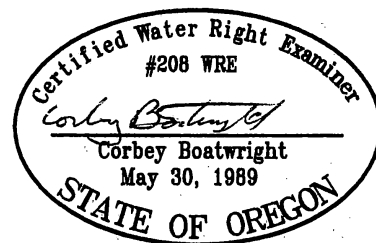

EXPIRES: 12/31/03

NOTE: This map is for the purpose of identifying the location of water rights and has no intent to dimension or locate property ownership lines.

R-88471