

SECTION

sec 20 TL 800

sec 21 TL 190

sec 16 TL 801

TOWNSHIP 45, RANGE 3E, W. M.




North

RECEIVED BY OWRD

APR 18 2013

SALEM, OR

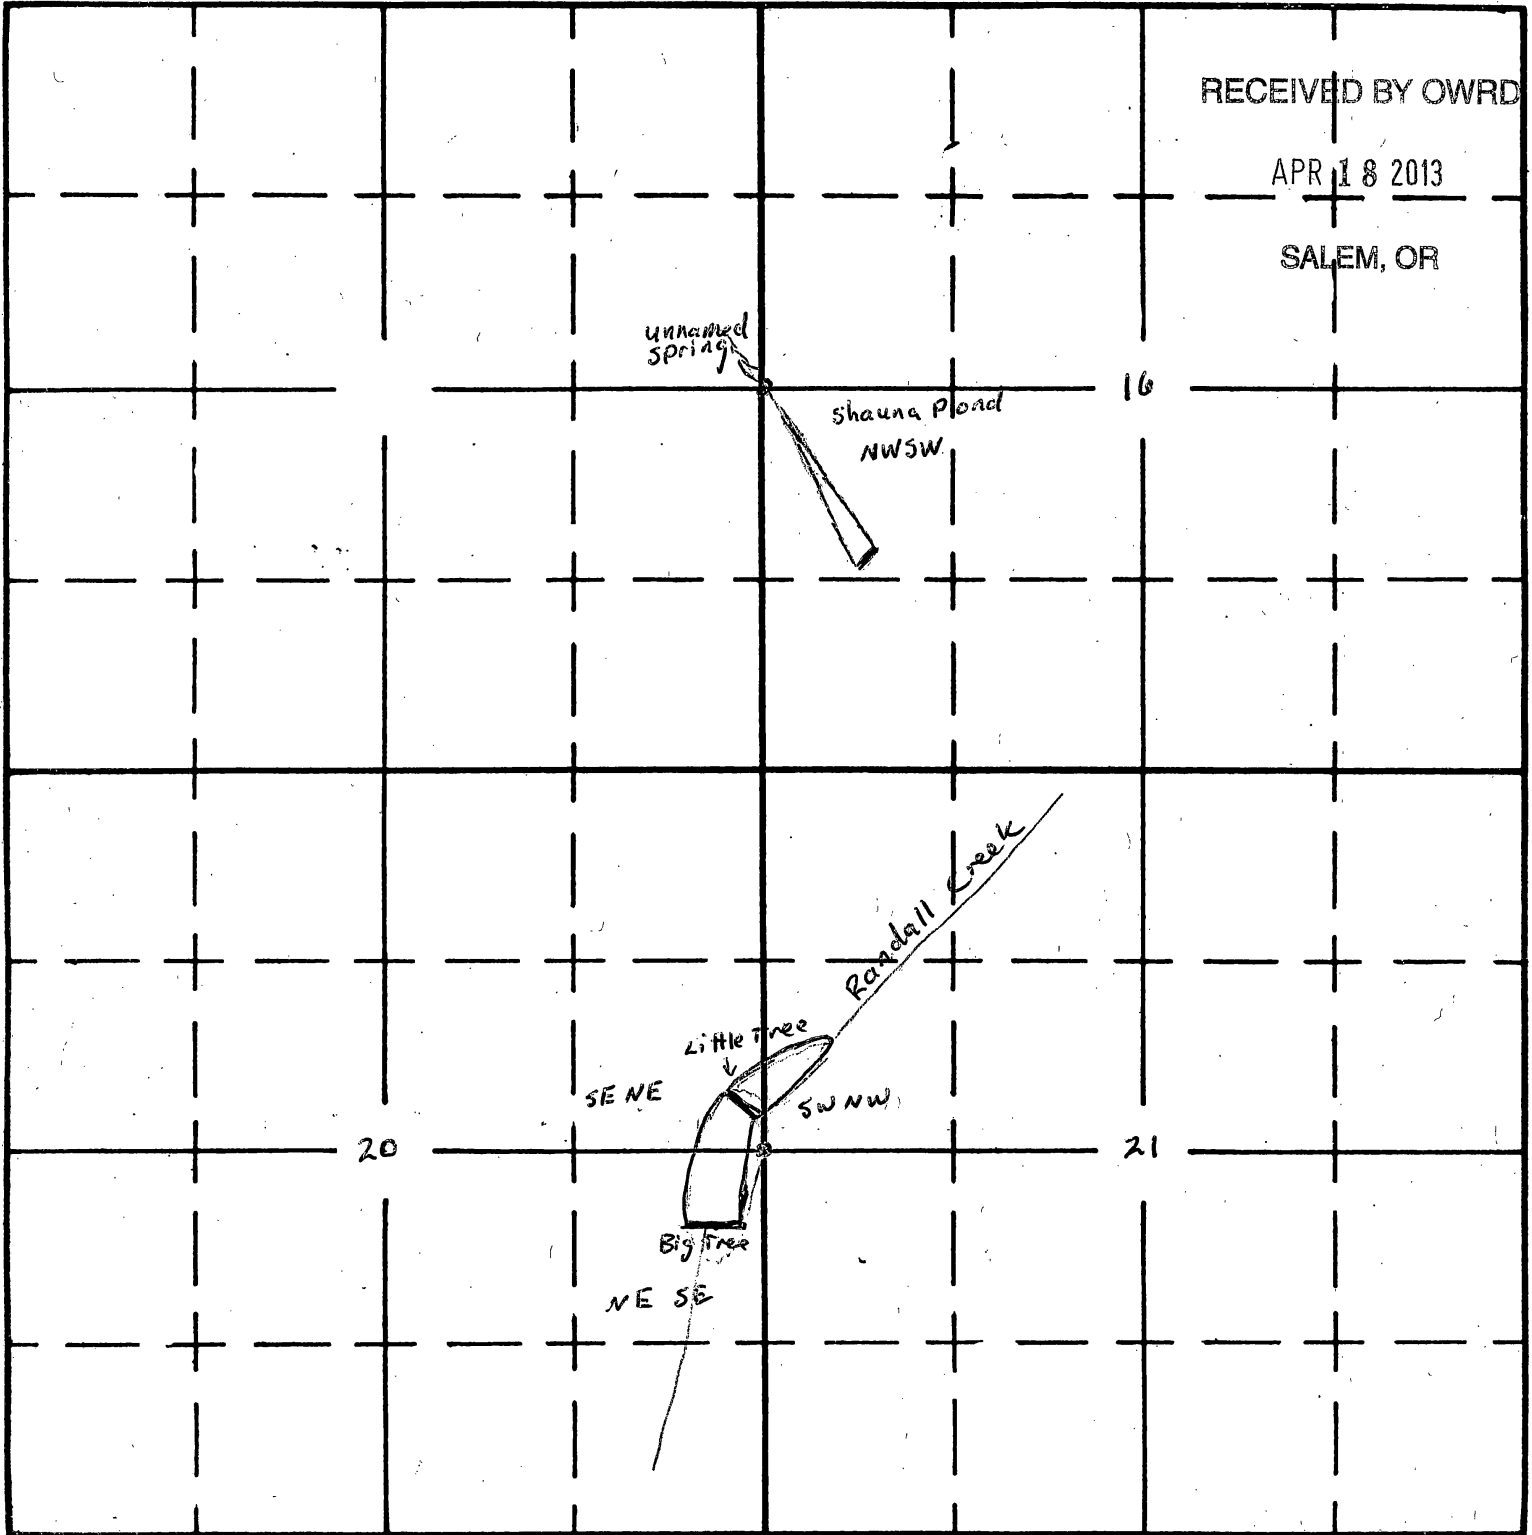

South

Big Tree Dam 559' S & 355' W from E 1/4 cor. section 20
 Little Tree Dam 311' N & 158' W from E 1/4 cor. section 20
 Shauna Pond Dam 1123' S & 648' E from W 1/4 cor. section 16

RECEIVED BY OWRD

NOV 16 2012

SALEM, OR

1" = 1370', R-07090