


RED FOR  
SE ONLY

MULTNOMAH COUNTY

①  
2N 1W 18  
& INDEX

$\frac{1}{4} = 400'$   
 $1" = 600'$   
SEE MAP 2N 1W

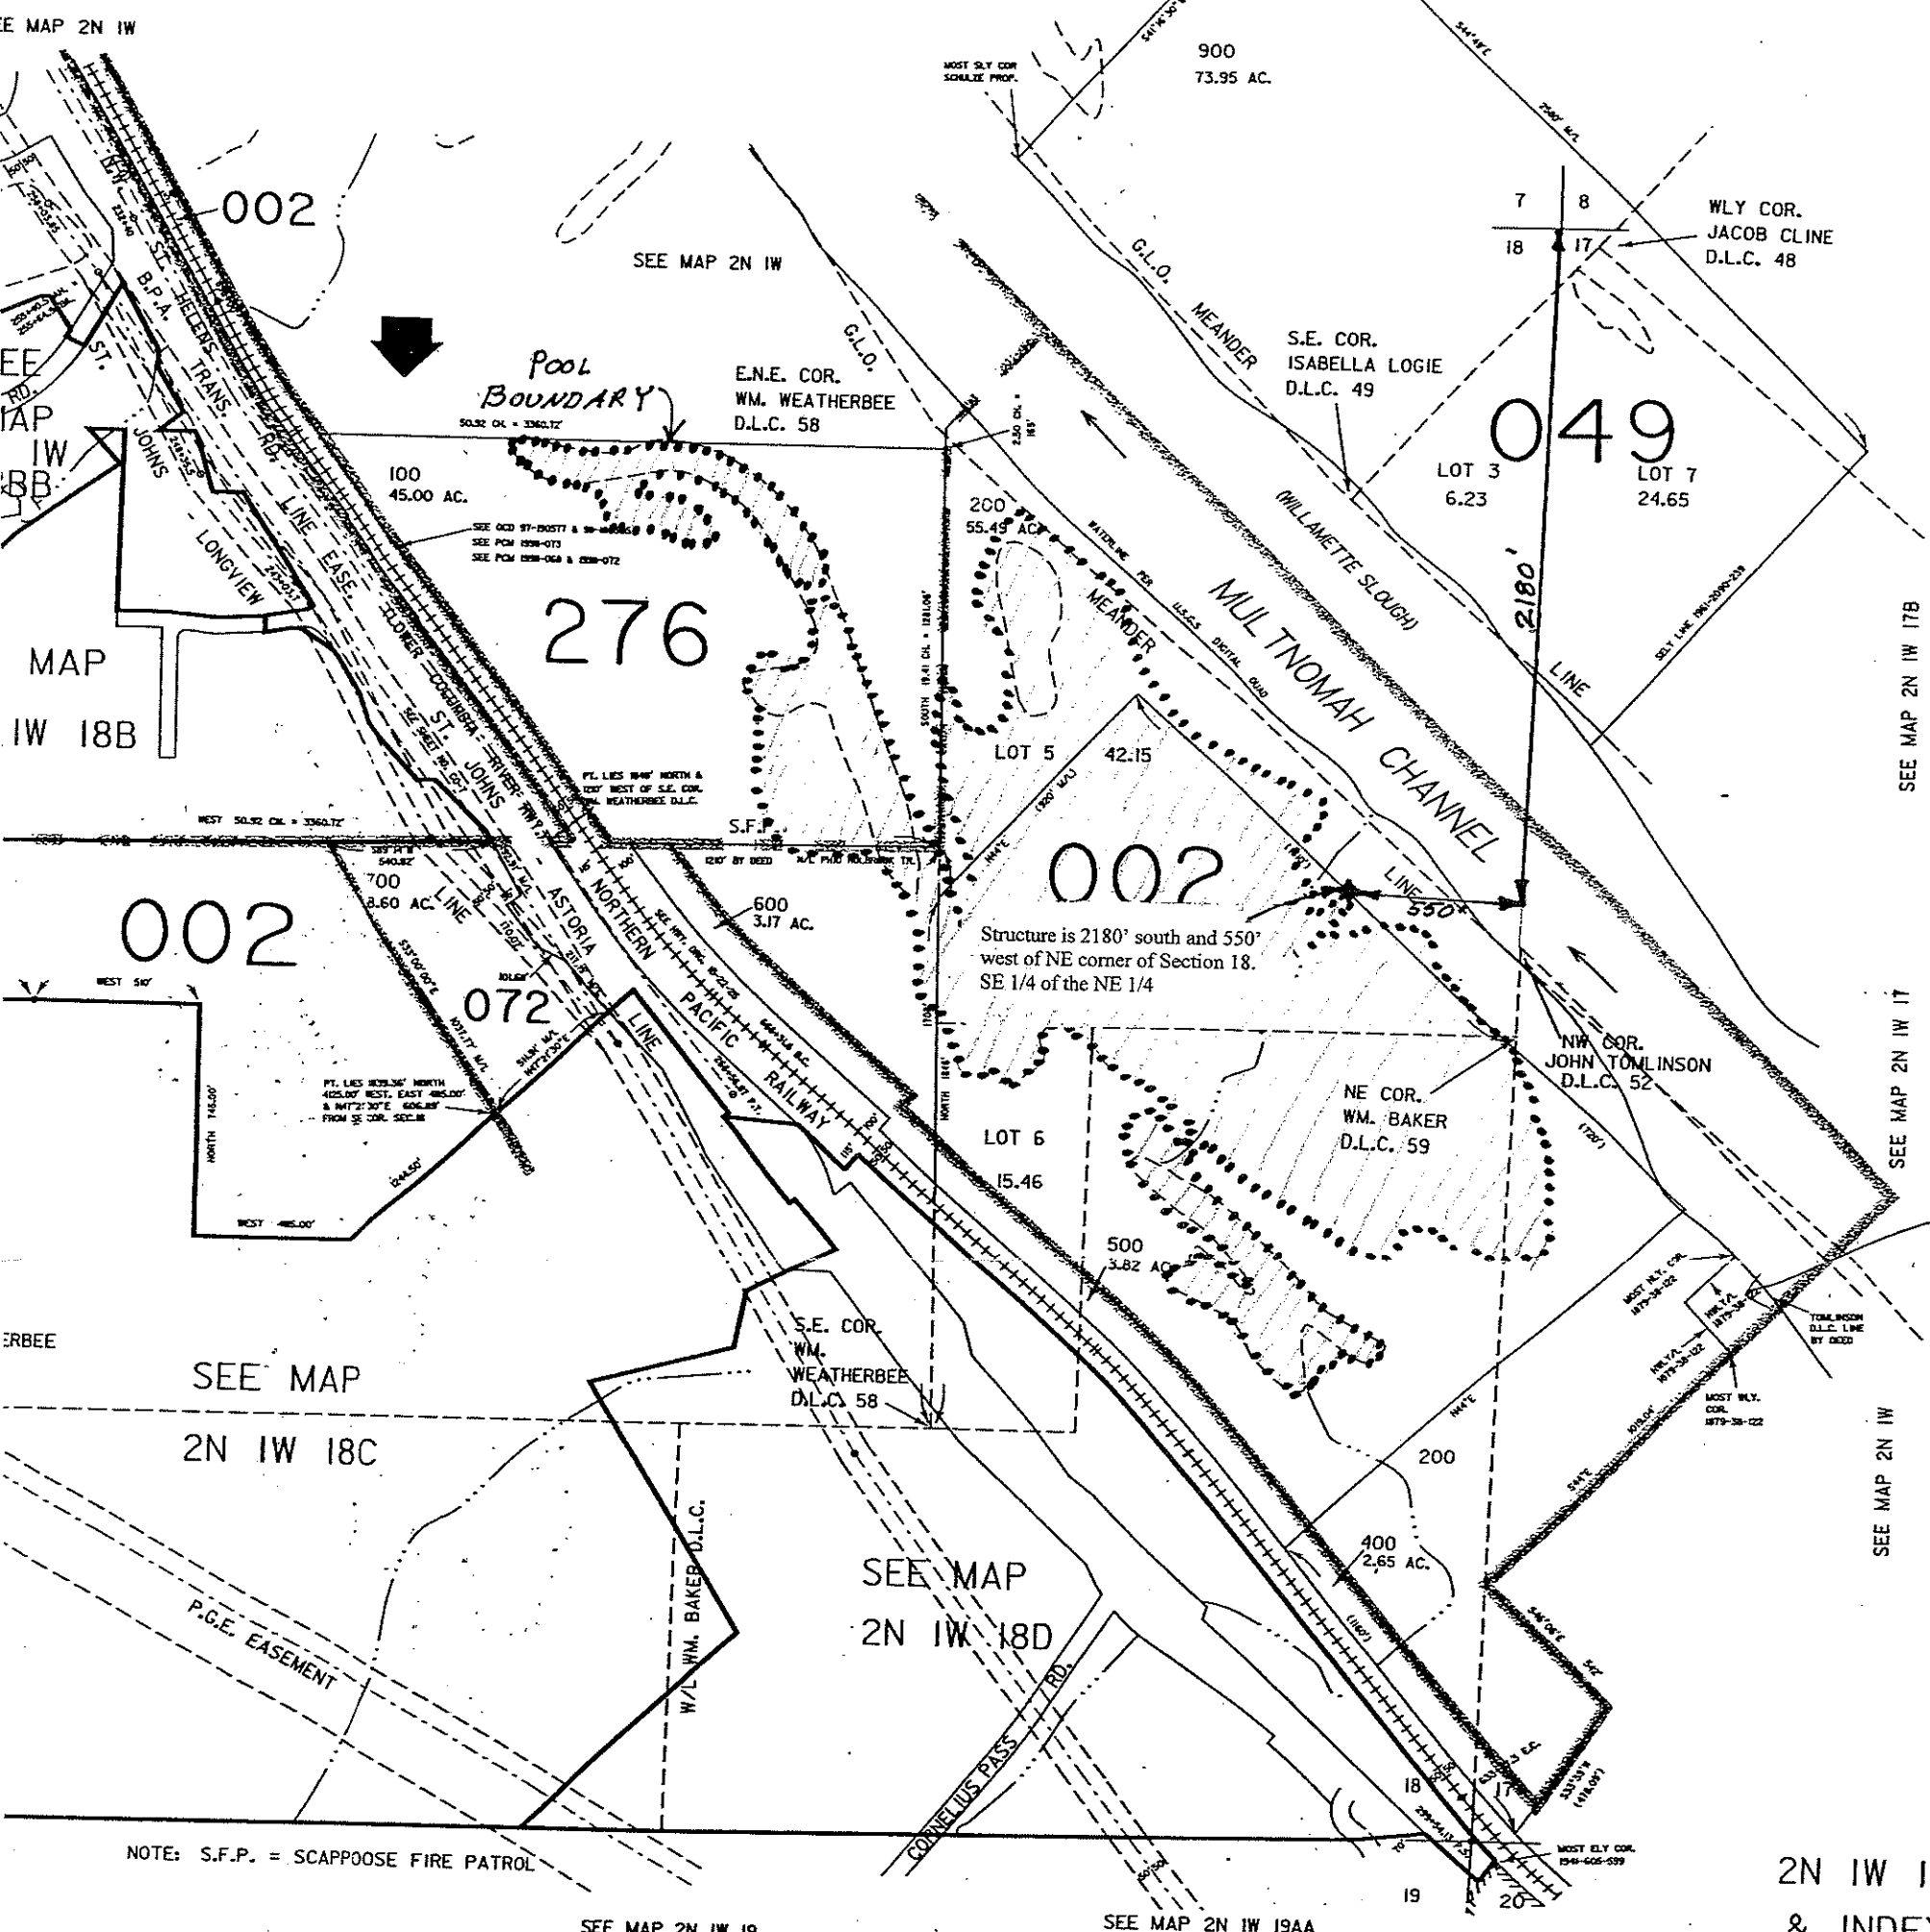

NOTE: S.F.P. = SCAPPOOSE FIRE PATROL

SEE MAP 2N 1W 19

SEE MAP 2N 1W 19AA

2N 1W 18  
& INDEX

app # R 85969

RECEIVED

MAR 29 2004

WATER RESOURCES DEPT.  
SALEM OREGON

ENYART BOTTOMS  
T2N,R1W, SECTION 18  
Tax lots 100, 200, 300  
Page 1/1

R85969

25-MAY-2004  
[map]