


T39S R8W Southeast Quarter Section 22

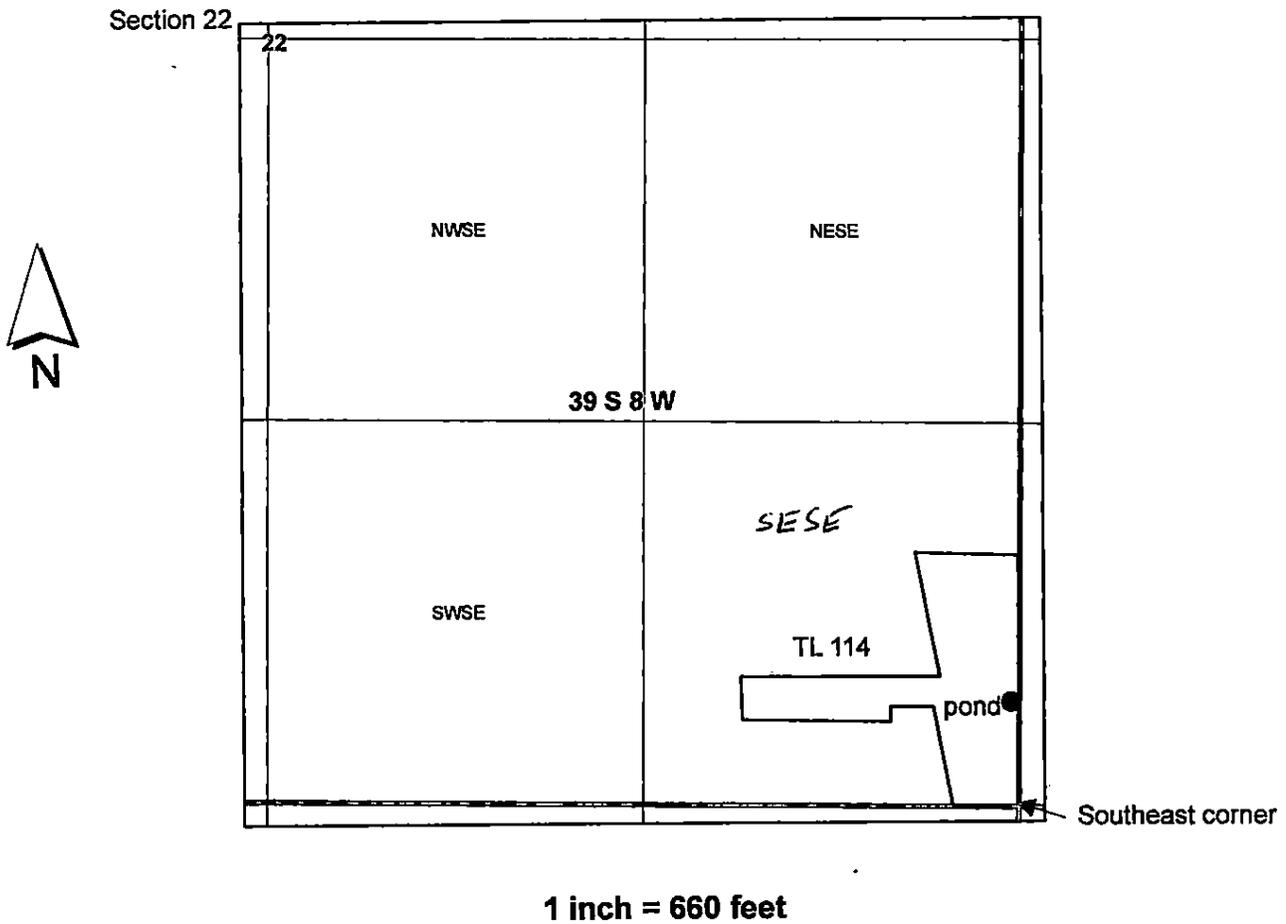

The pond is located approximately 366 ft north and 30 ft west of the southeast corner of Section 22.

RECEIVED BY OWRD

NOV 01 2017

SALEM, OR

R-88474