


Terry Behrens

1" = 1320'

Tax Lot:

Township 8 South, Range 1 East, Section 17 & 20, Tax Lot 800

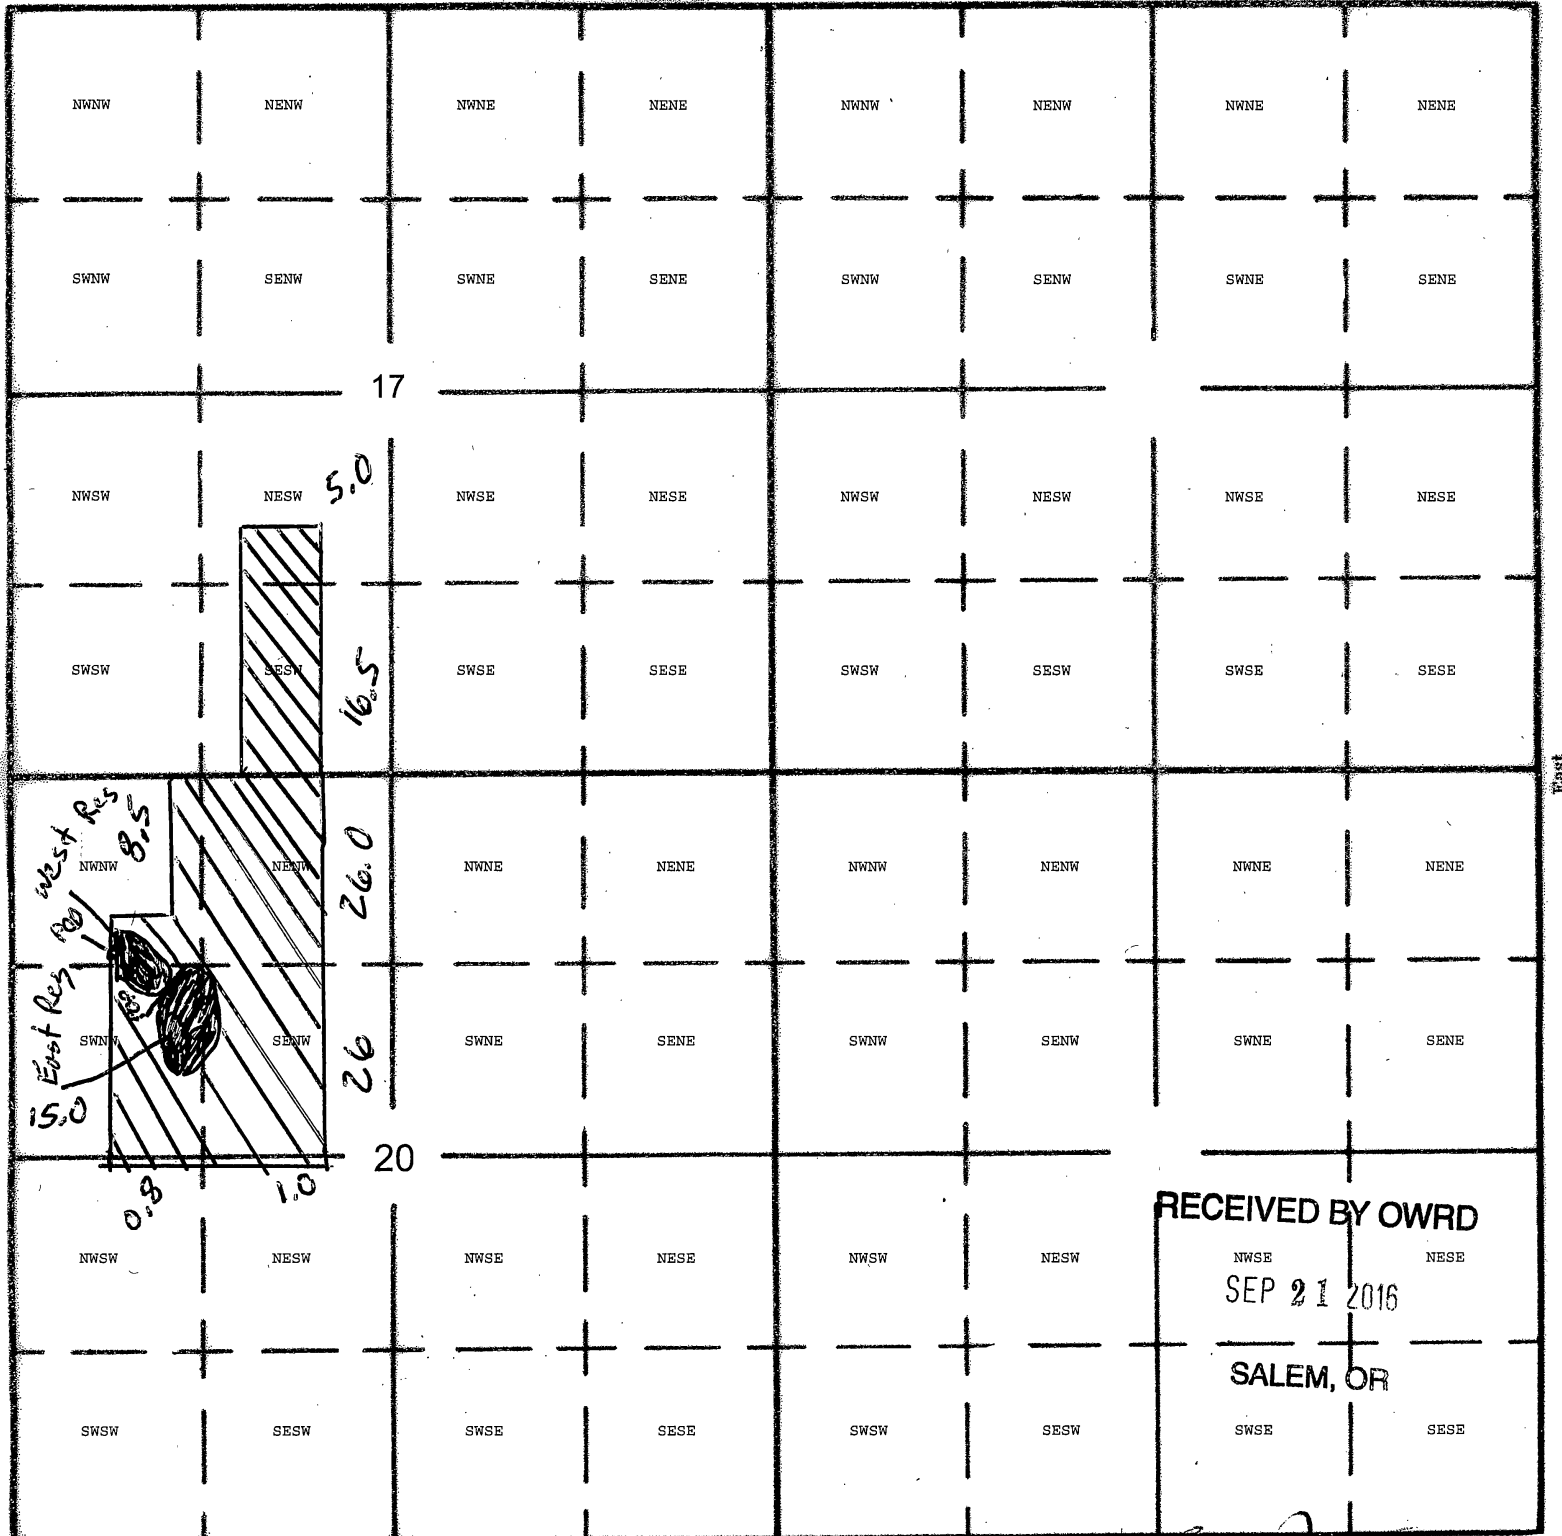

98.8 acres

South

RECEIVED BY OWRD

NWSE NESE
SEP 21 2016

SALEM, OR

SWSE SESE

Handwritten signature and date: AR 12/6 7/7/16

Dam Location East: 1350 South and 1500 West from NE Corner Section 20
 Dam Location West: 1200 South and 1950 West from NE Corner Section 20
 POD: 1350 South and 1500 West from NE Corner Section 20
 POD: 1200 South and 1950 West from NE Corner Section 20

R-88223