



TO SALEM

TURNER

WIPPER RD


Center Corner of
Sec 32, T 85 R 2W

RECEIVED
NOV 20 2018
OWRD

NE COR OF SW COR SECTION 32 T 85 R 2W
TAXLOT ~~082W32 601 & 500~~ Remapped as 092W05 1500
"CENTER" OF DAM: UTM NAD-83 METERS (ZONE 10)


N 4,964,076
E 503,097
720' South and 690' West of the
Center Corner of Sec. 32 T 85 R 2W

DAM / RESERVOIR LOCATION

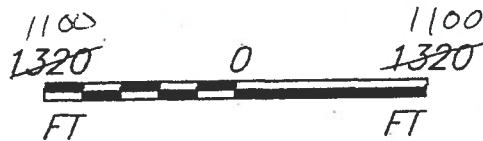

RECEIVED
APR 07 2003
WATER RESOURCES DEPT.
SALEM, OREGON

APP. R-85547
PER. R-13825

Sheet 1 of 1	Drawing No. ORLWCS-0305	 NRCS Natural Resources Conservation Service United States Department of Agriculture
	File Name	

McKinney Creek WRP
LOCATION MAP
ORS 537.409 PERMITTING
Marion County, OR

Designed	CMS	Date	3/03
Drawn	CMS		3/03
Checked			
Approved			
Title			

R-88670 Supercolina