

AUER FARMS LLC Club Pond

RECEIVED

NOV 05 2018


OWRD

1" = 1320'

Tax Lot:



Township 9 South, Range 5 West, Section 21, Tax Lot 100

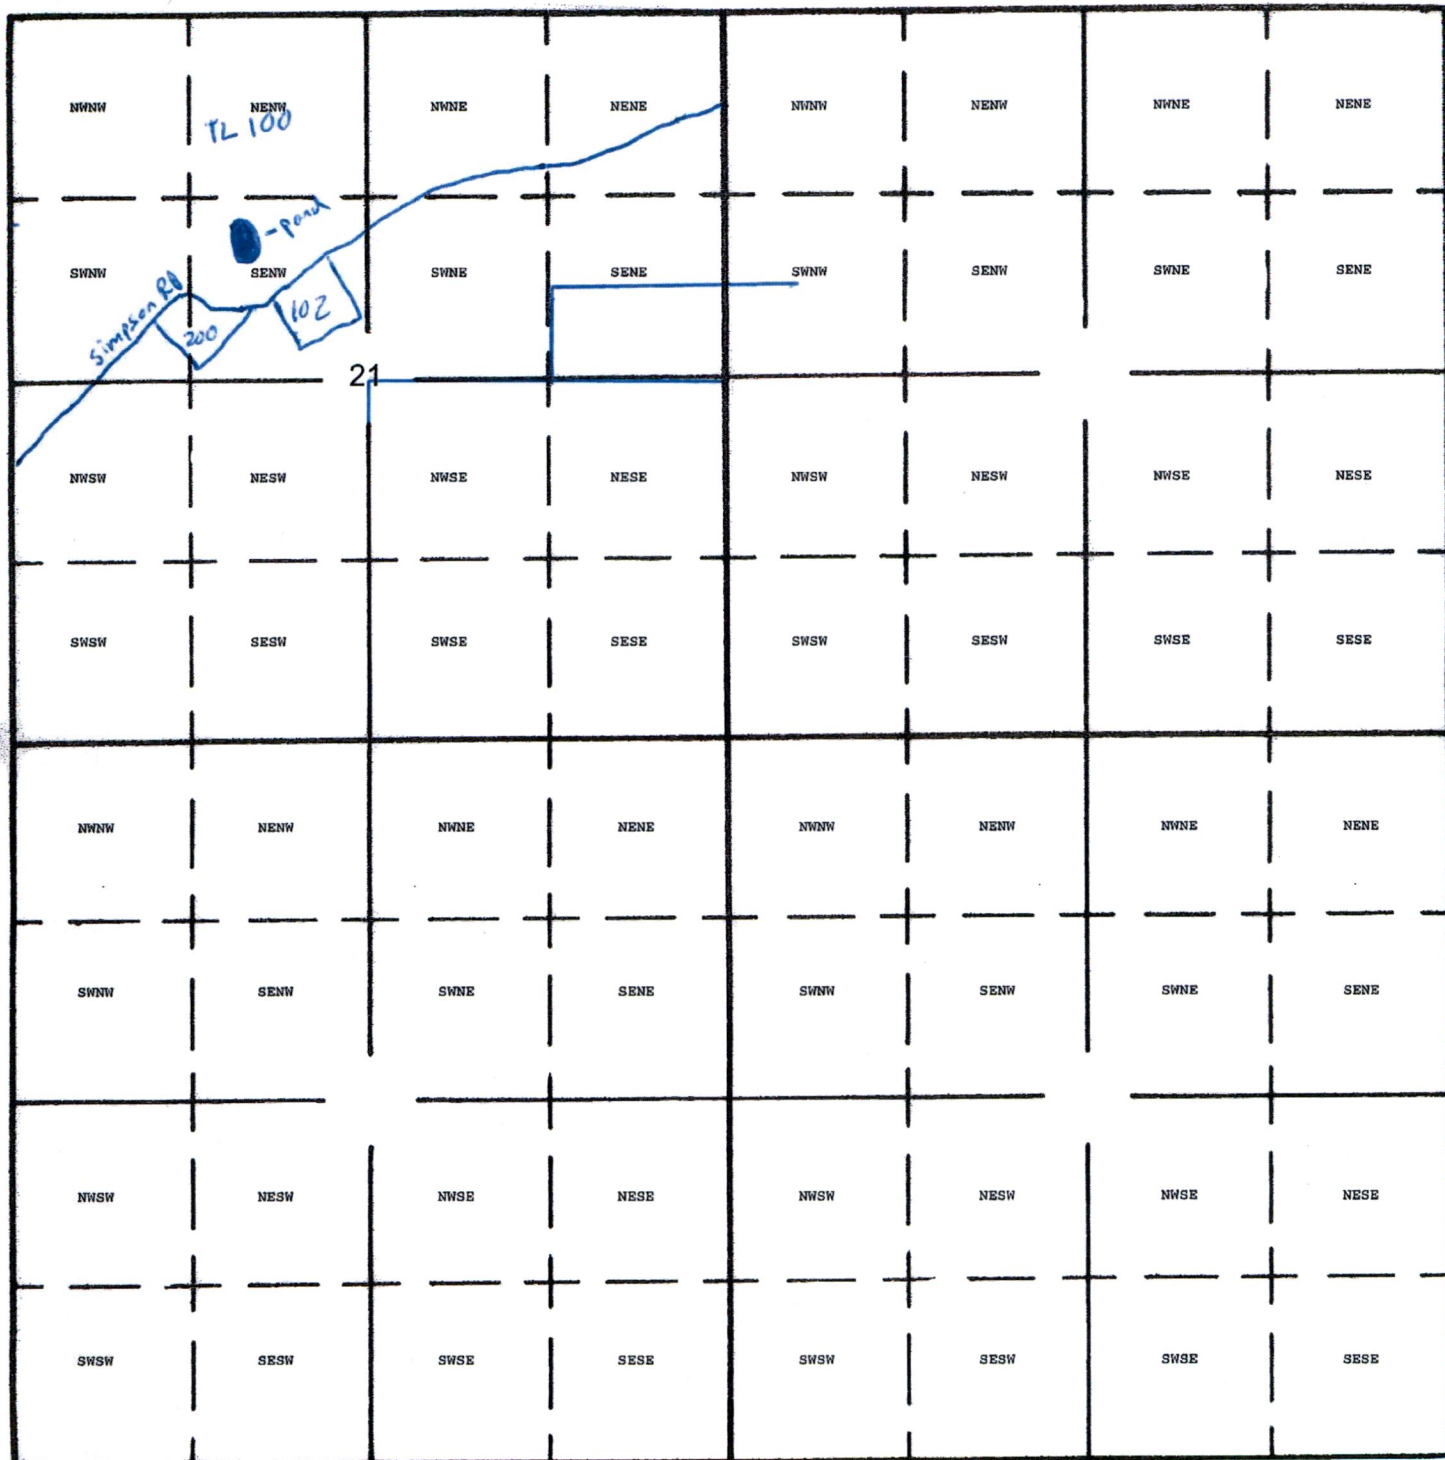

Dam Location: 1,520 South and 1,640 East from NW Corner Section 21

Dam Location West:

POD:

POD:

John W. Auers Mgr *AUER FARMS LLC*
10-29-2018

R00677