


SEC. 36, T.35S., R.14W., W.M.

SCALE 1" = 1320 FEET

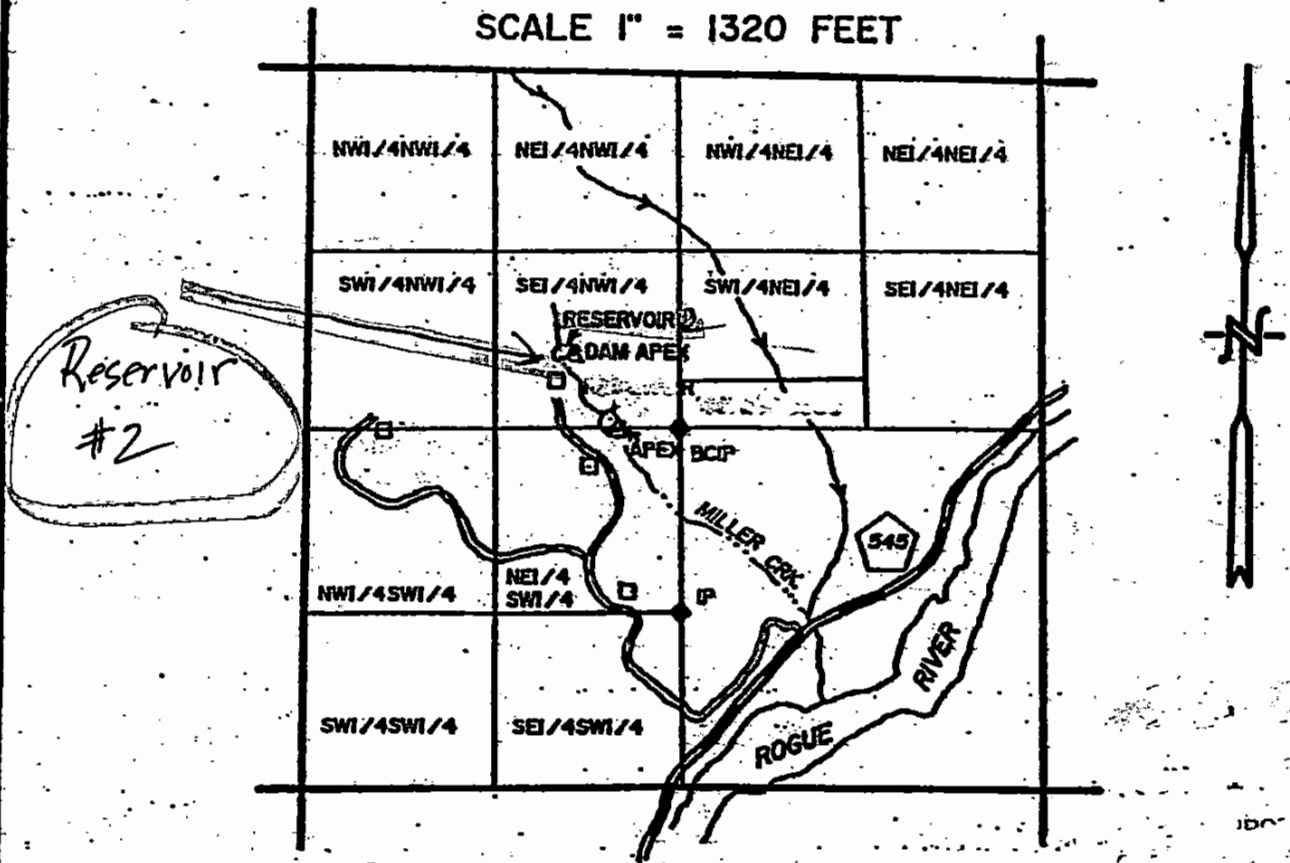

² RESERVOIR DAM APEX ± 520' N & 740' W OF C1/4 SECTION 36.

APPLICATION NO. _____ PERMIT NO. _____
 IN THE NAME OF _____ LIDIA T. DONNELLY
 MAPPED BY THOMAS J. HOWIE, _____

THE PREPARATION OF THIS MAP IS FOR THE PURPOSE OF IDENTIFYING THE LOCATION OF A WATER RIGHT ONLY AND HAS NO INTENT TO PROVIDE DIMENSIONS OR THE LOCATION OF PROPERTY OWNERSHIP LINES.

RECEIVED
 RECEIVED
 MAR 15 2019
 FEB 25 2019
 OWRD

OWRD

R-88760