


Reservoir Application Map
Samantha Kopp
T.26S. R.7S Section 25
Douglas County
Scale: 1" = 400'

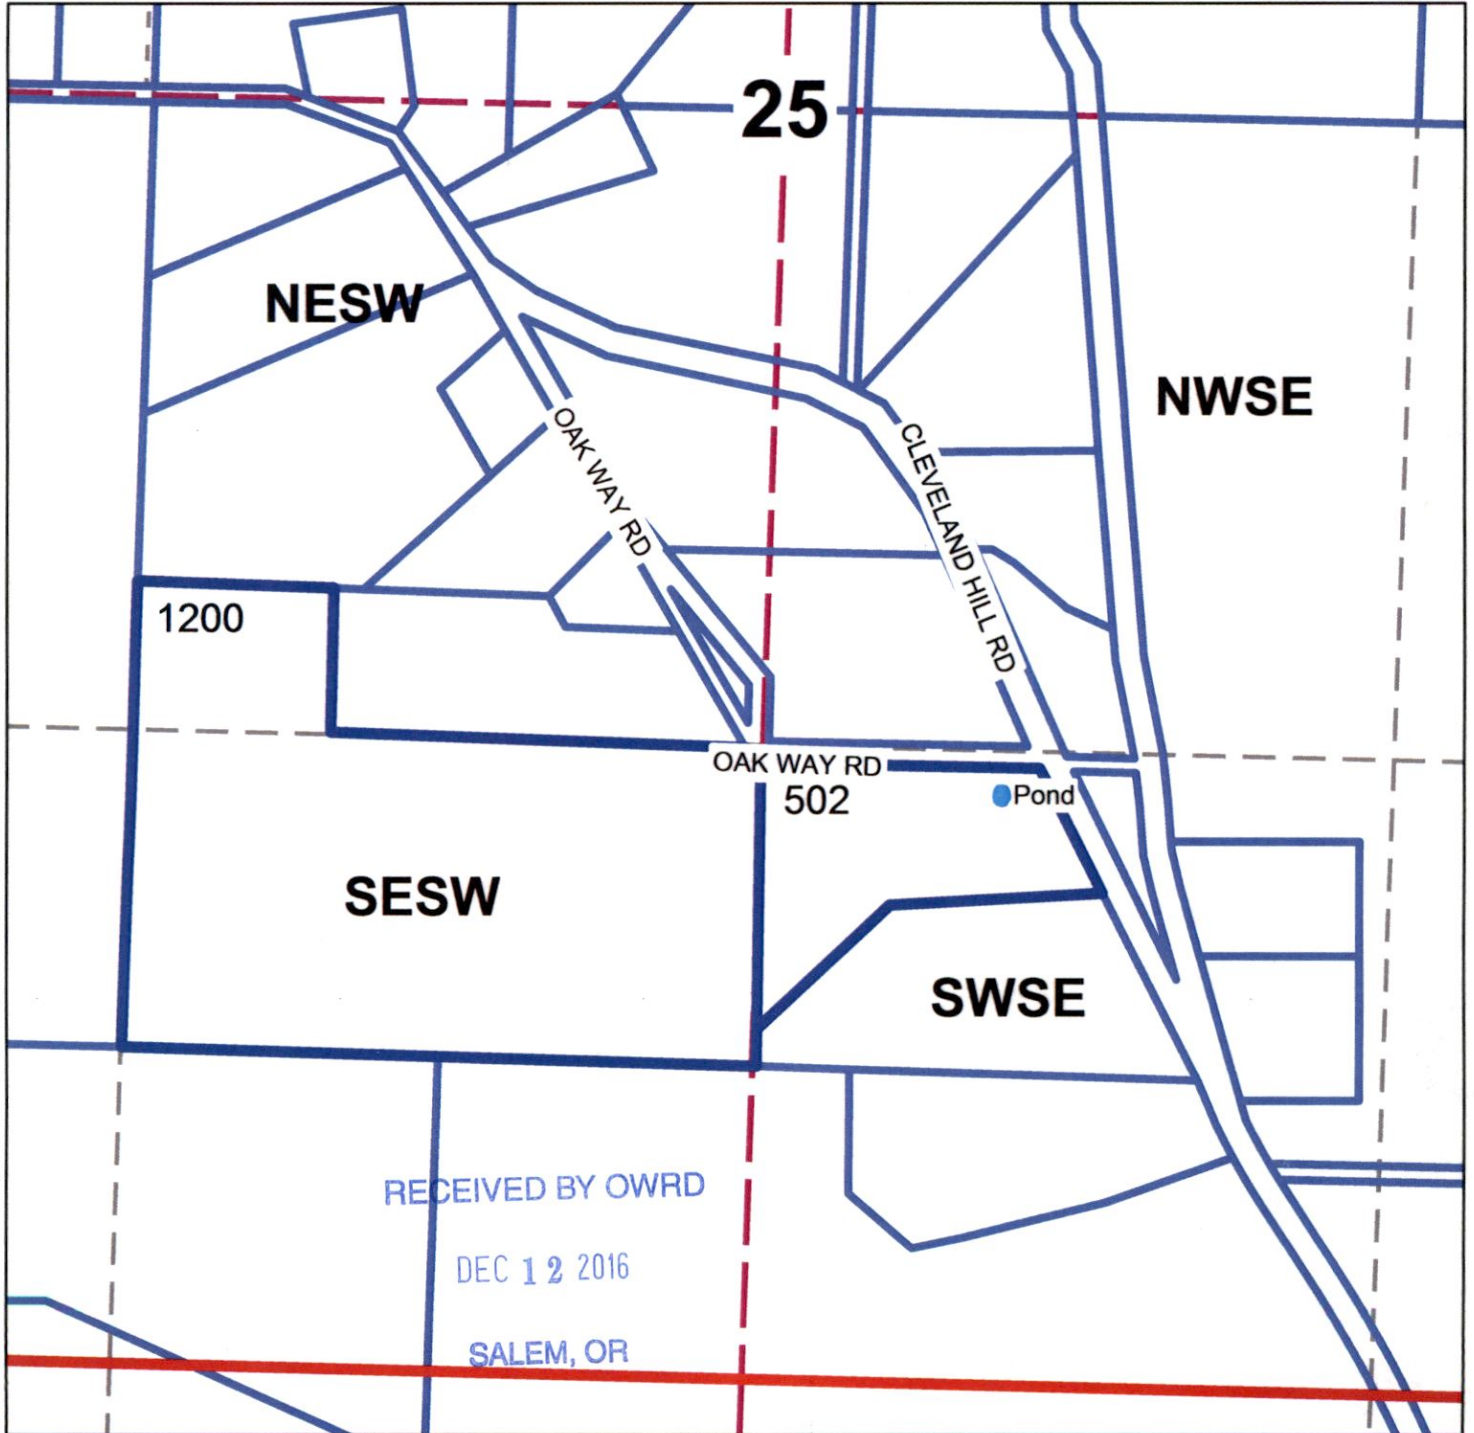

Pond is located 1430 ft. South and 520 ft. East from the center of Section 25.

R-88344

