

RECEIVED


AUG 20 2019



1" = 1320'

Tax Lot:

Township 8 South, Range 4 West, Section 33, Tax Lot 601 NESV OWRD

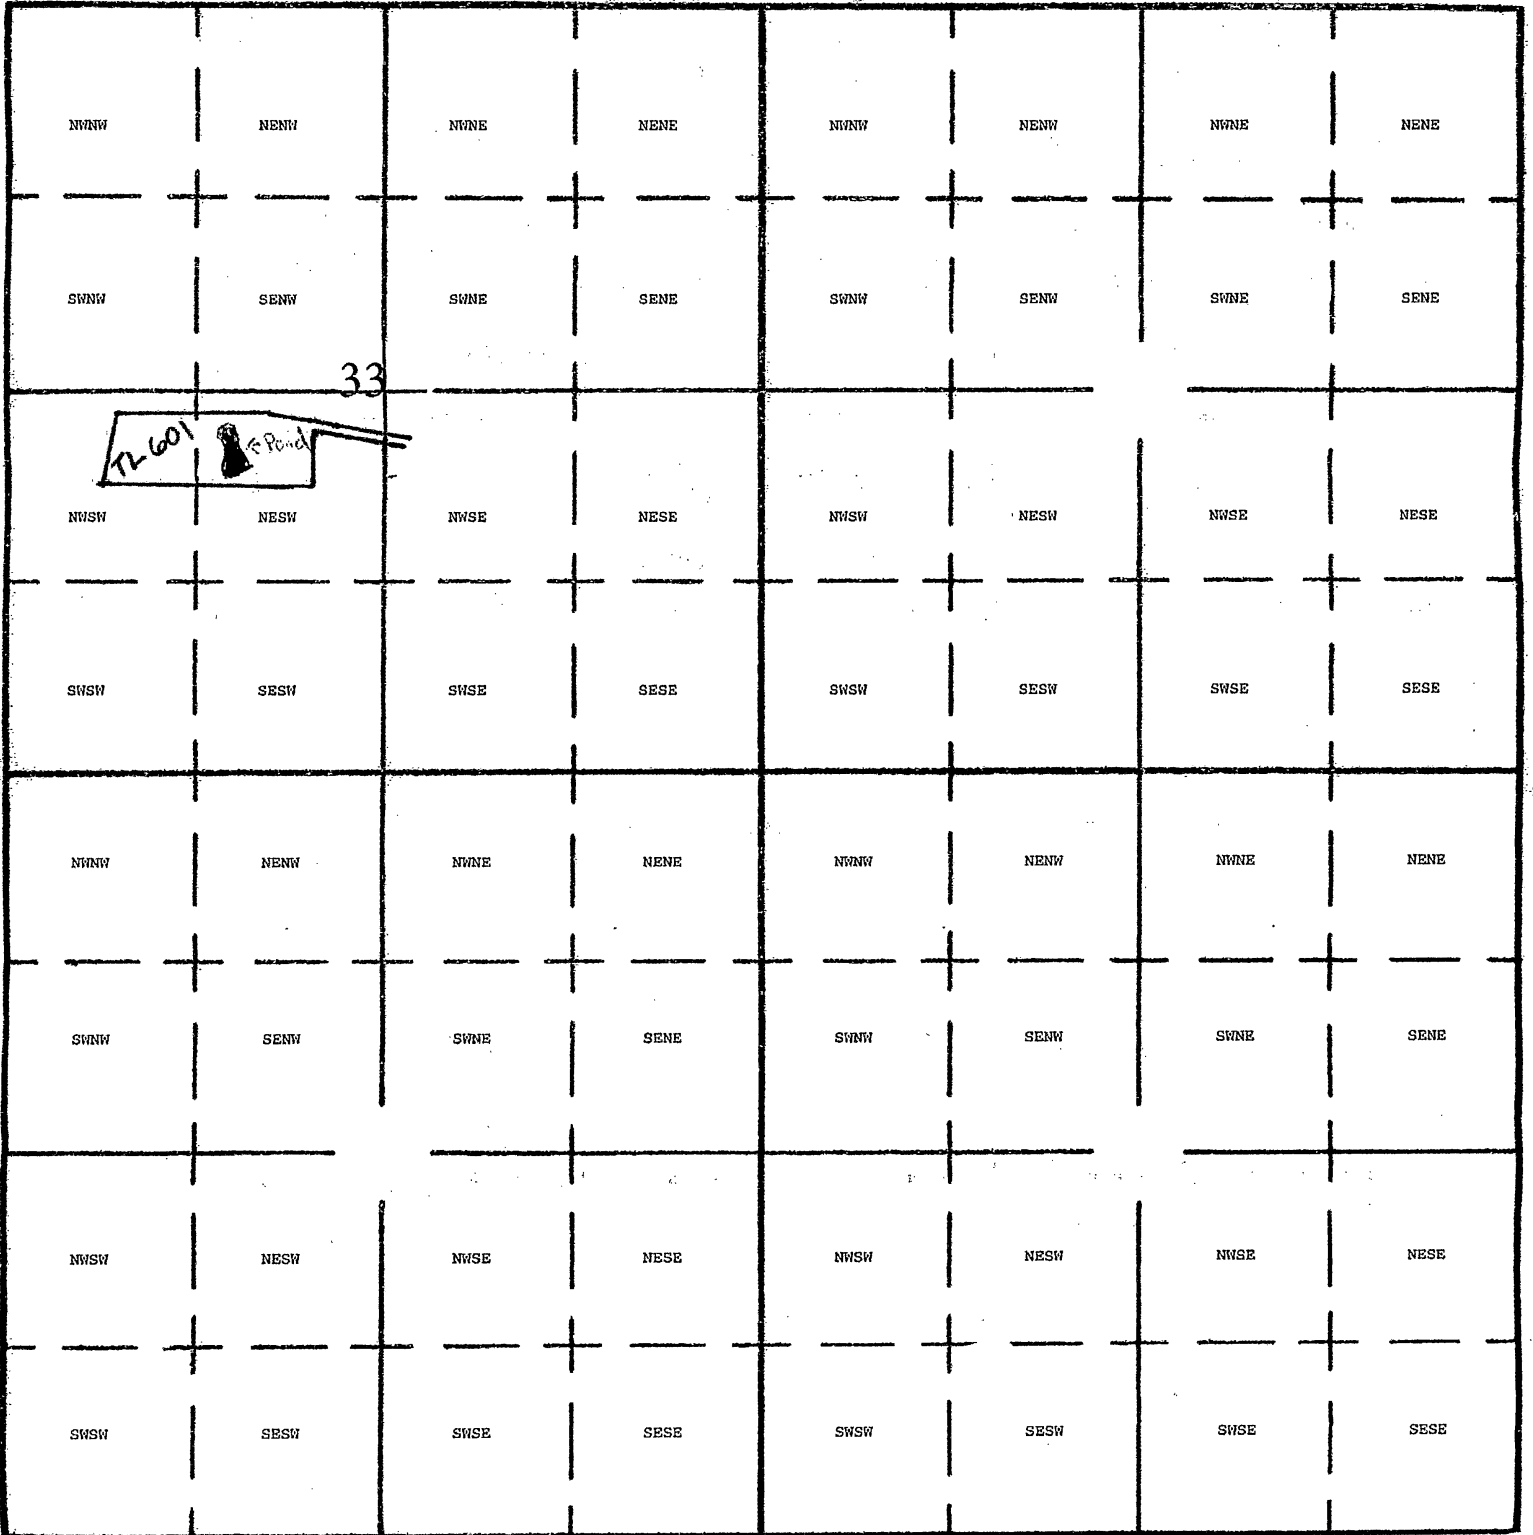

Dam Location: 590 Feet South and 1070 Feet West from Center of Section 33

AUG 12 2019

OWRD

R-88733

Account Books
1-29-19