

Robertson Map
1" = 1320'

Tax Lot:


Township 9 South, Range 6 West, Section 23 & 24, Tax Lot 101 & 200



RECEIVED

AUG 29 2019


OWRD

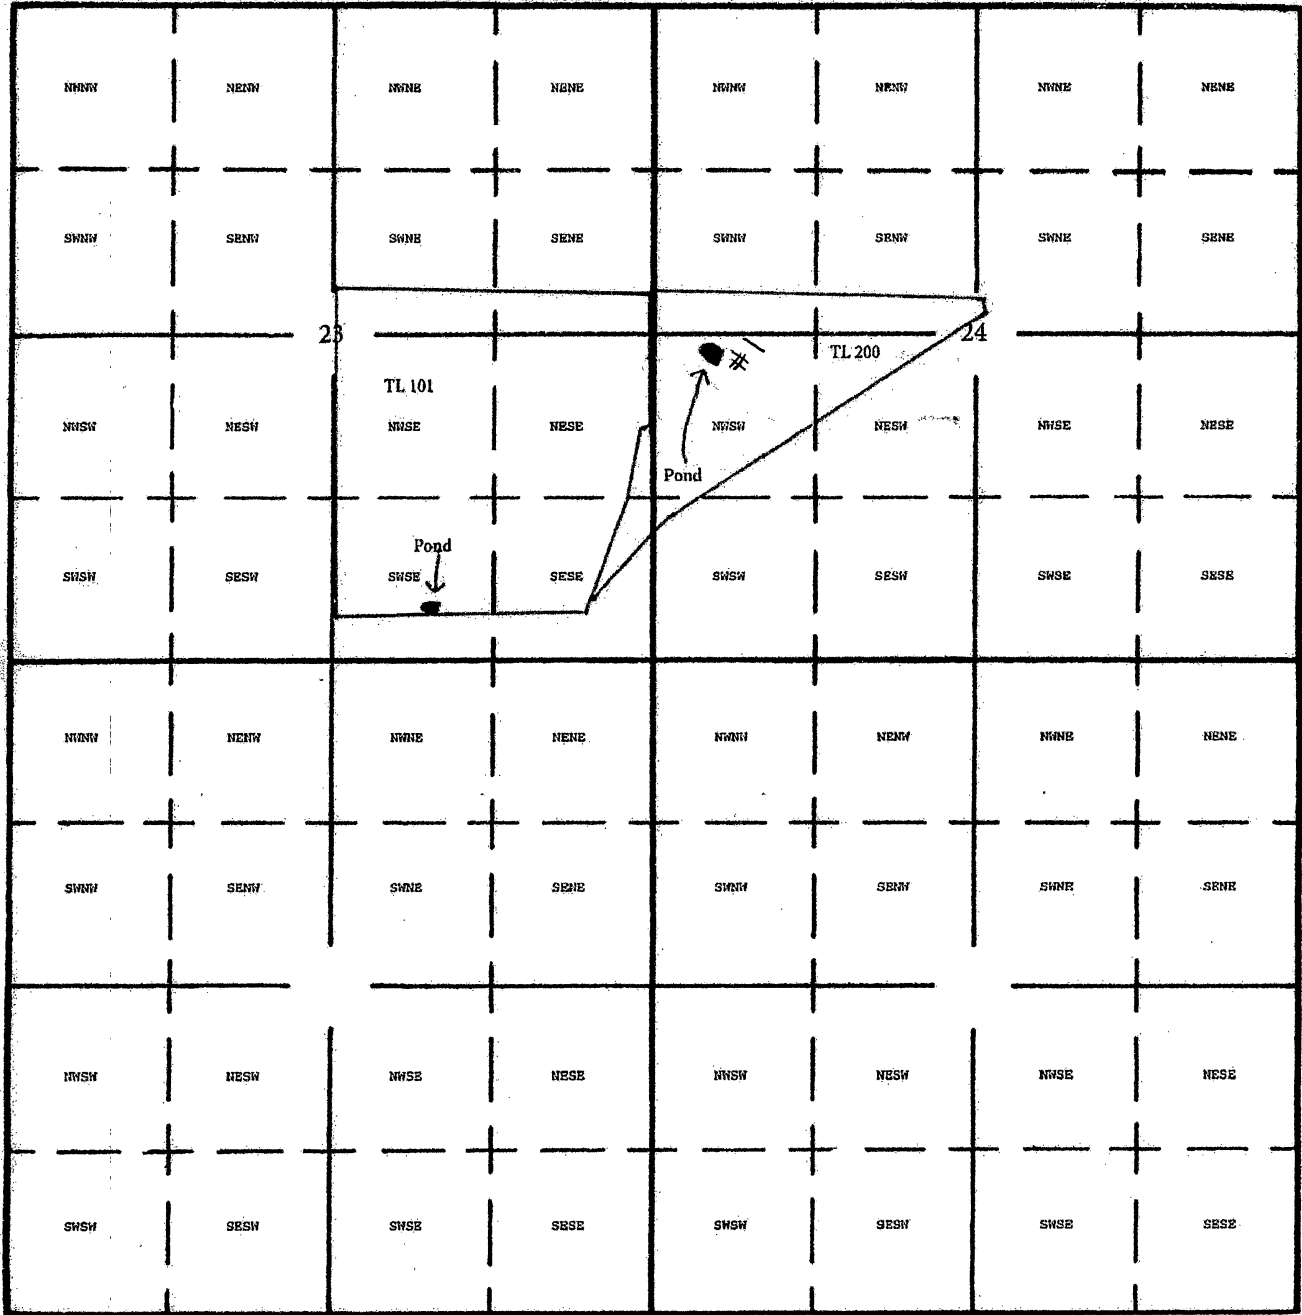

Dam: 405 North & 1725 West from SE Corner Section 23
Dam: 2,400 North & 525 East from SW Corner Section 24

Just Robertson
08-01-2019

Polk County Map

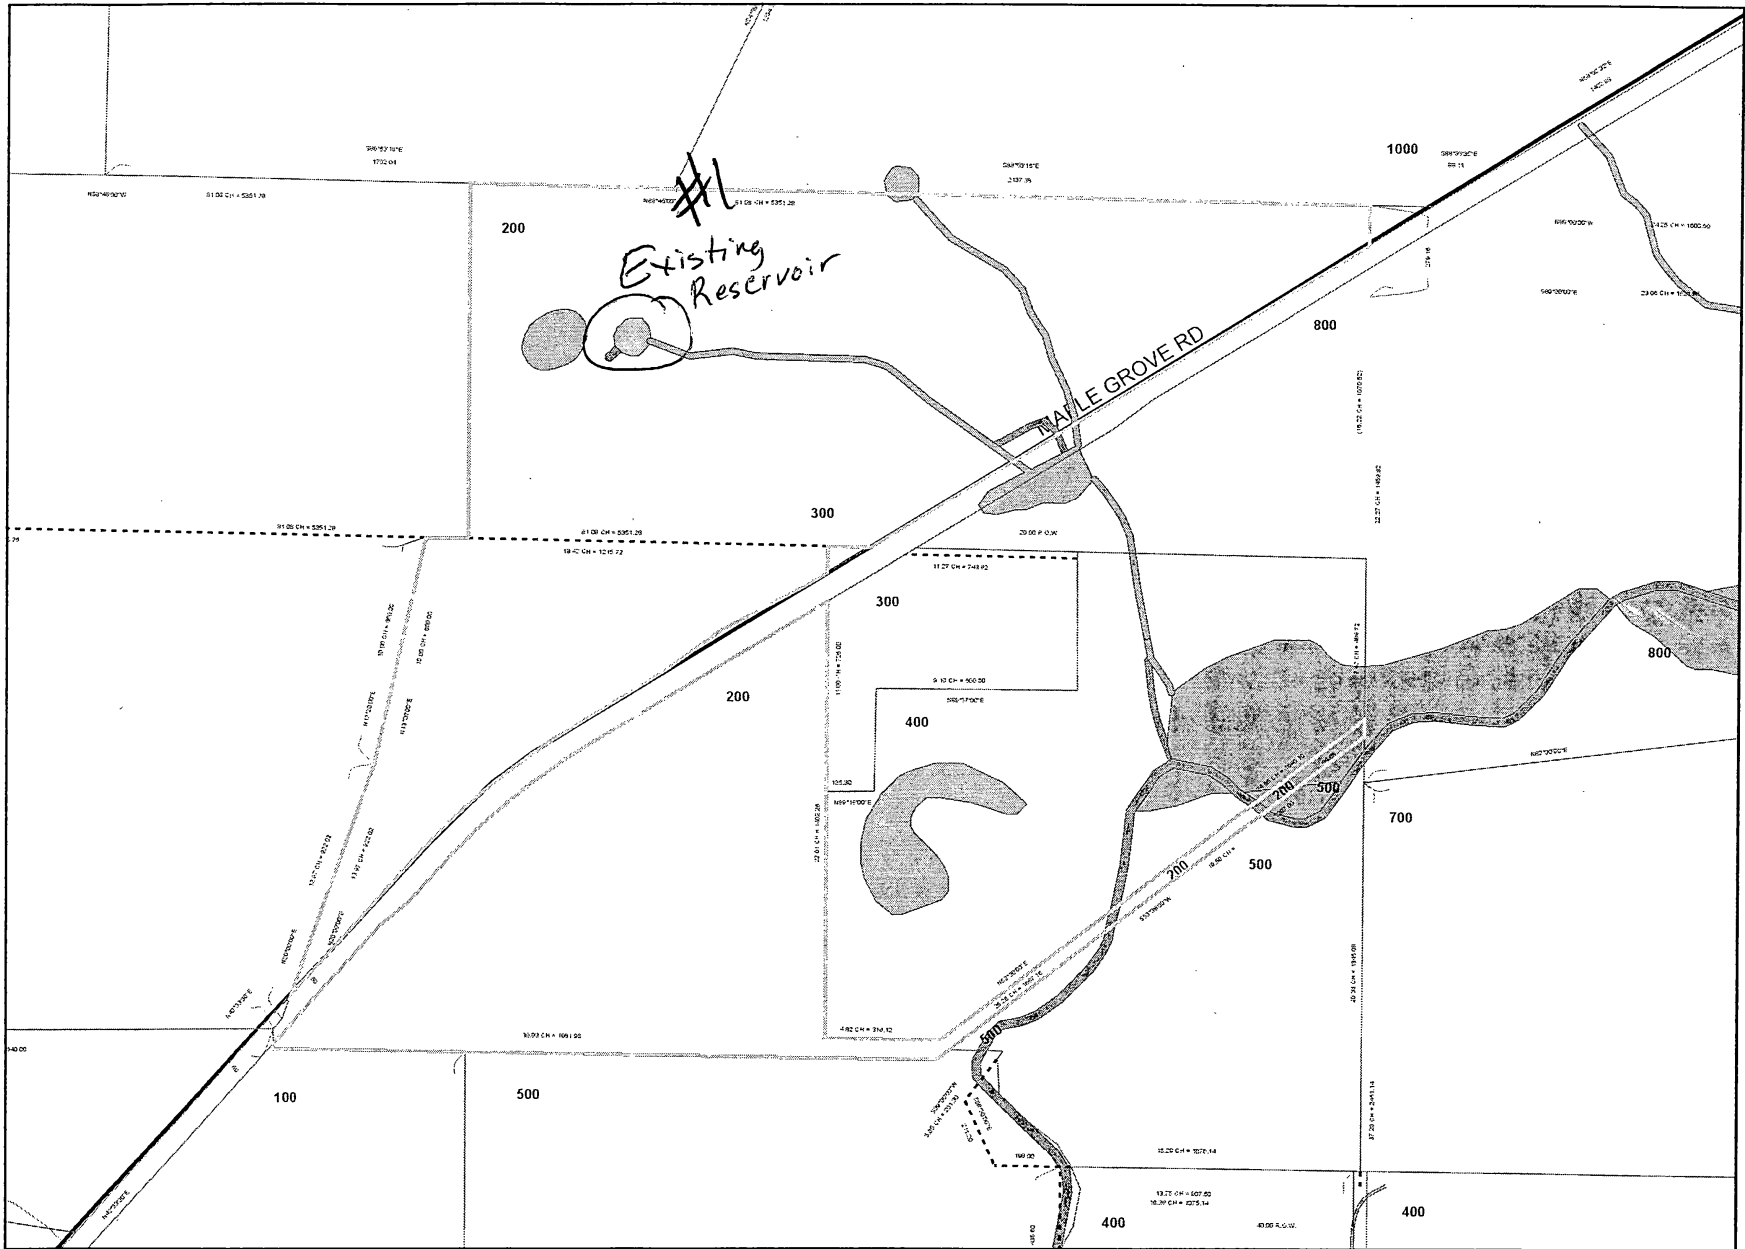

	City Limits		Taxlots

10-50720

RECEIVED

AUG 29 2019

OWRD

Date: 7/29/2019

This map was produced from the Polk County geographic databases to support its governmental activities. This product is for informational purposes and may not have been prepared for, or be suitable for legal, engineering, or surveying purposes. The county is not responsible for any map errors, possible misuse, or misinterpretation. To report a map error, please call (503)623-0713.