


Riddle Farms

1" = 1320'

Tax Lot:

Township 8 South, Range 5 West, Section 13 & 24, Tax Lot 600

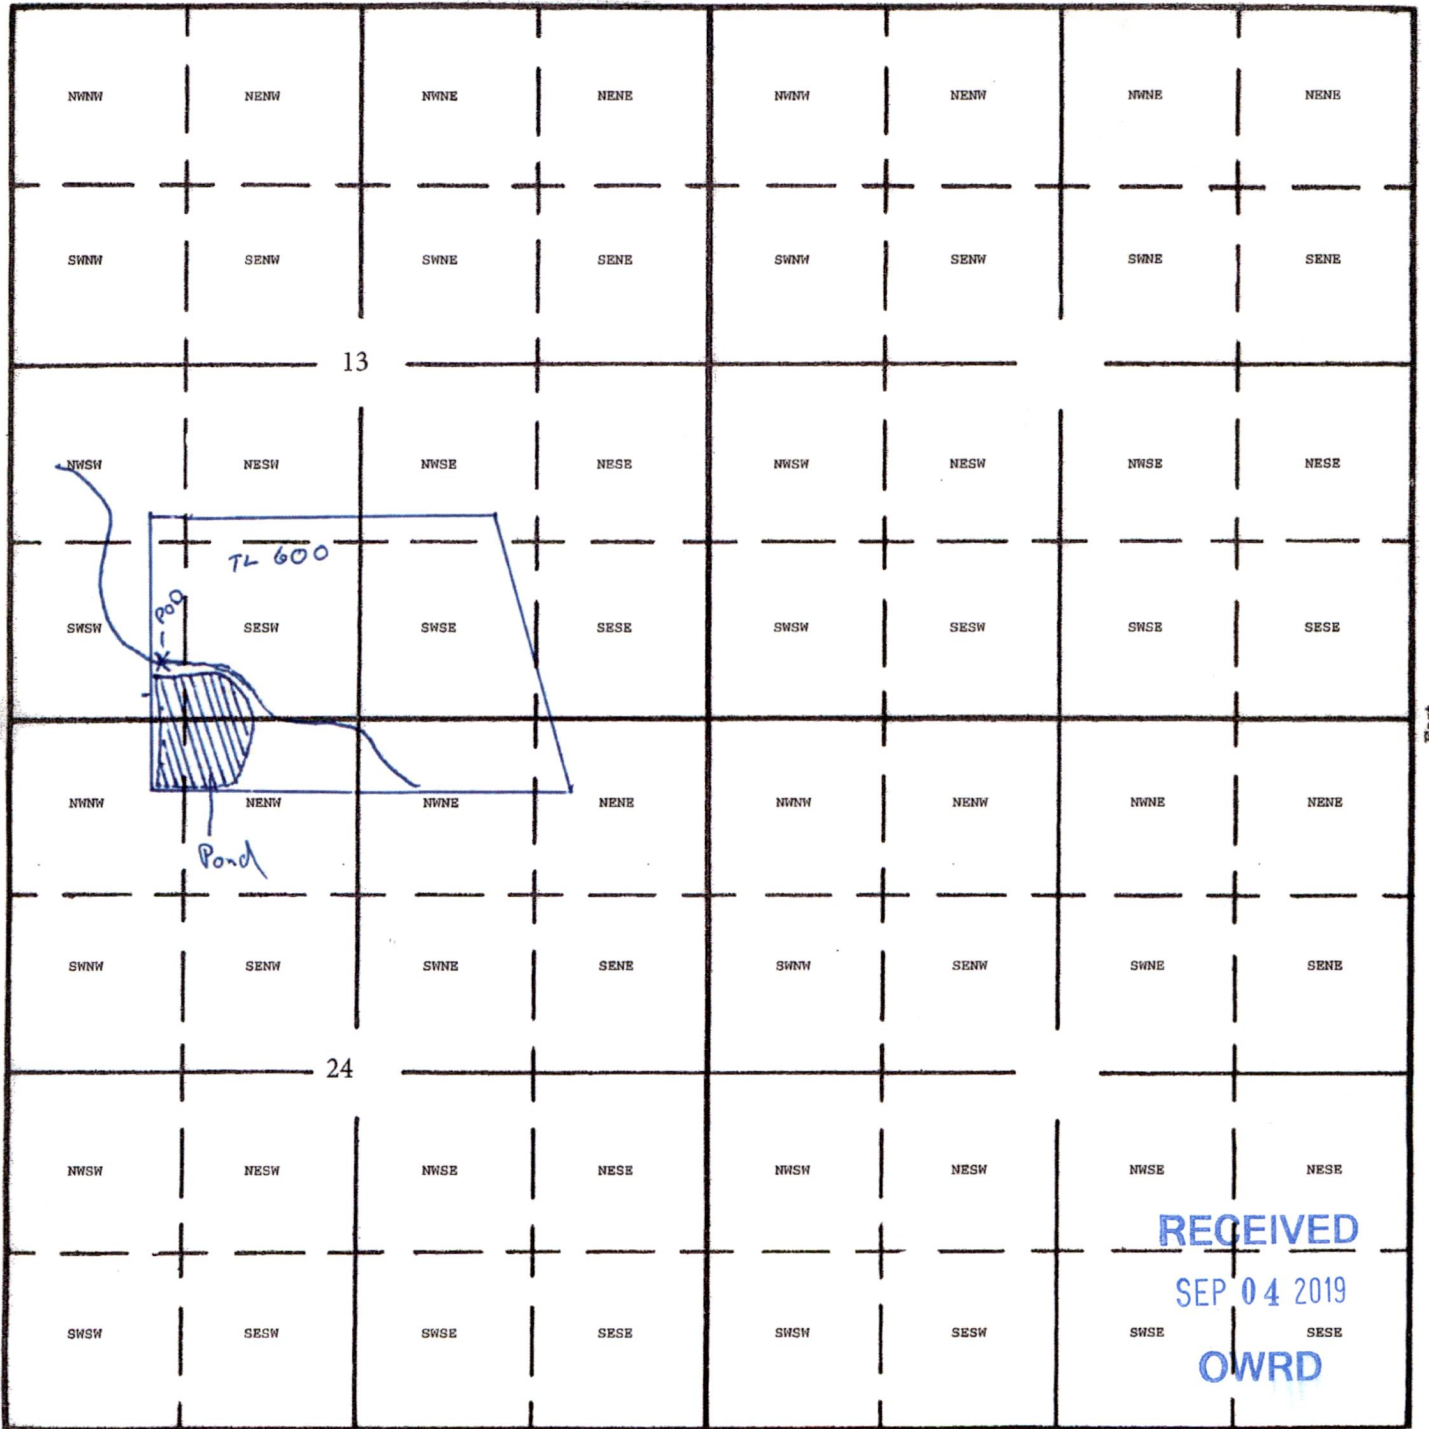

RECEIVED
SEP 04 2019
OWRD

POD: 1150 East 400 North from SW corner Sec 13
POD:

RECEIVED
AUG 22 2019
OWRD

R-88740