

RECEIVED

JAN 21 2020

OWRD


Marc Willcutts

1" = 1320'

Tax Lot:



Township 3 South, Range 3 West, Section 23, Tax Lot 609 & 610

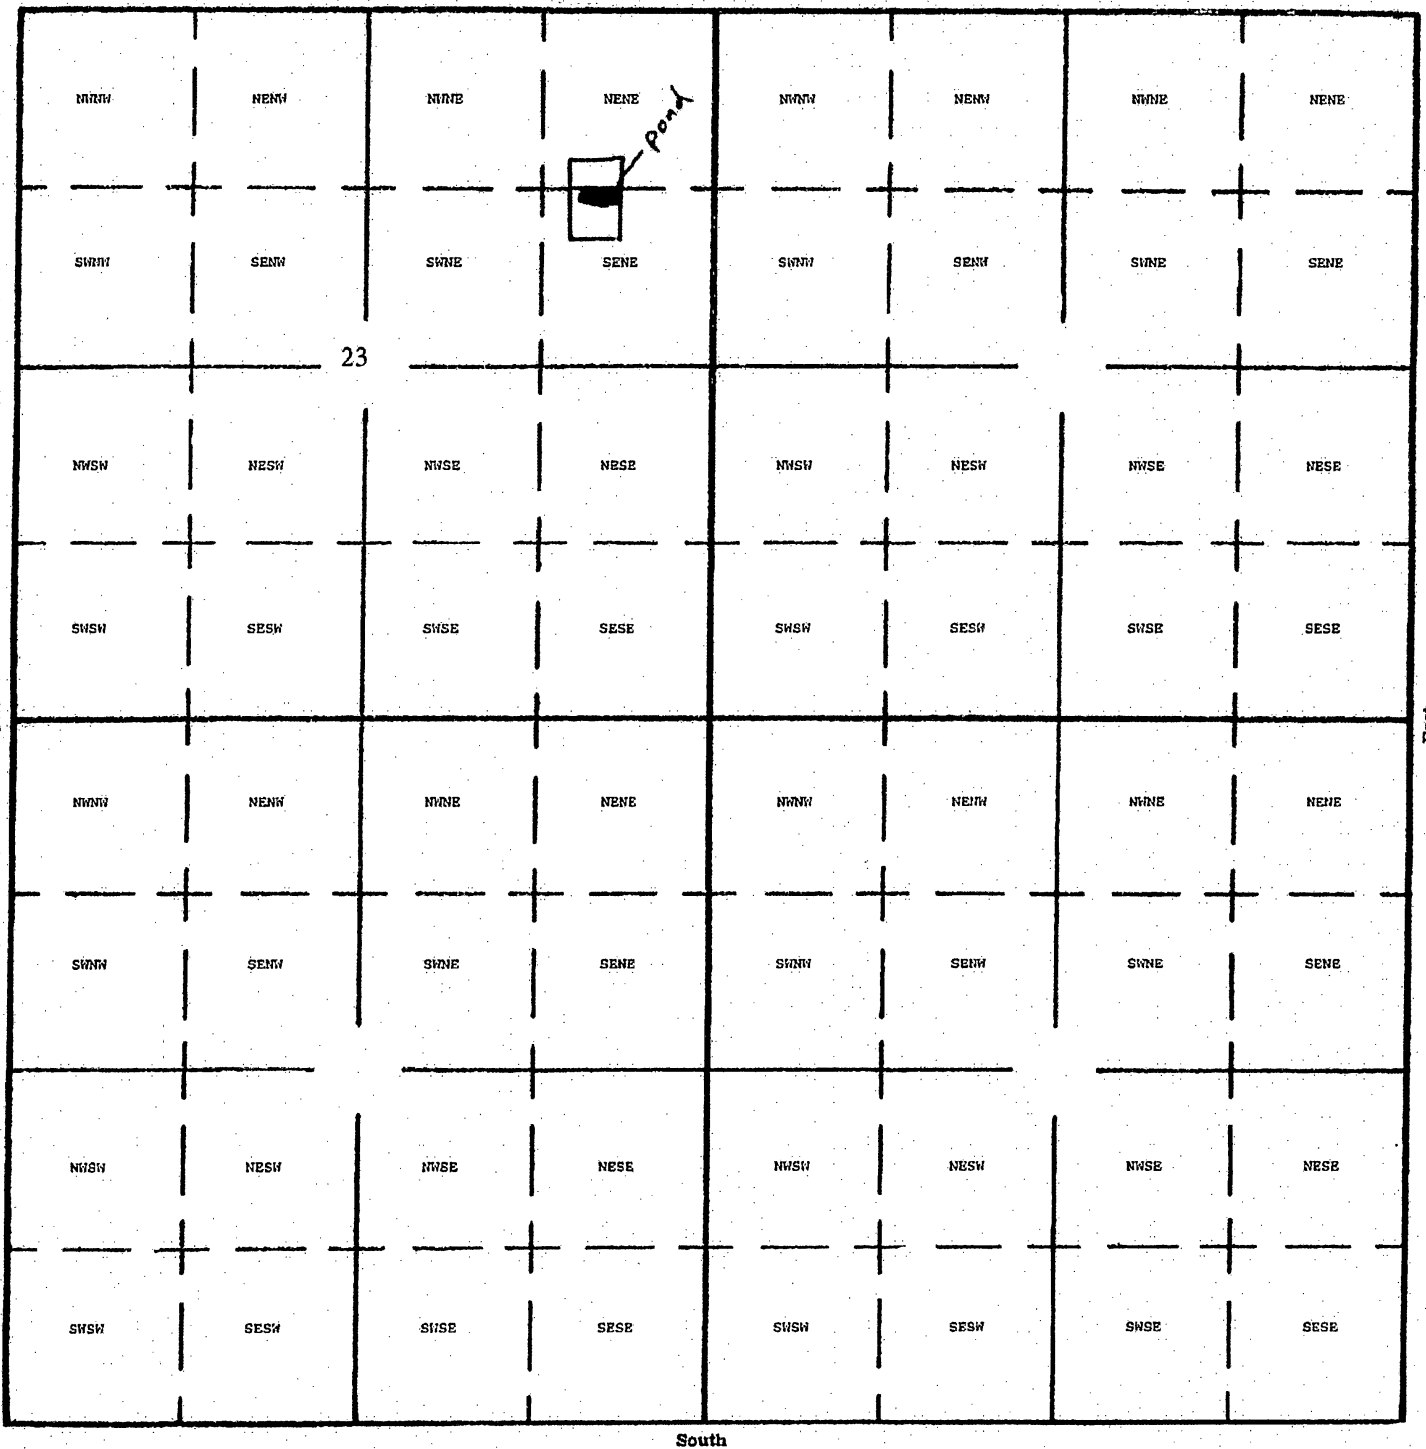

Dam Location: 1375 South and 690 West from NE Corner Section 23

R-88794