


# Herbert Farms Inundation Map



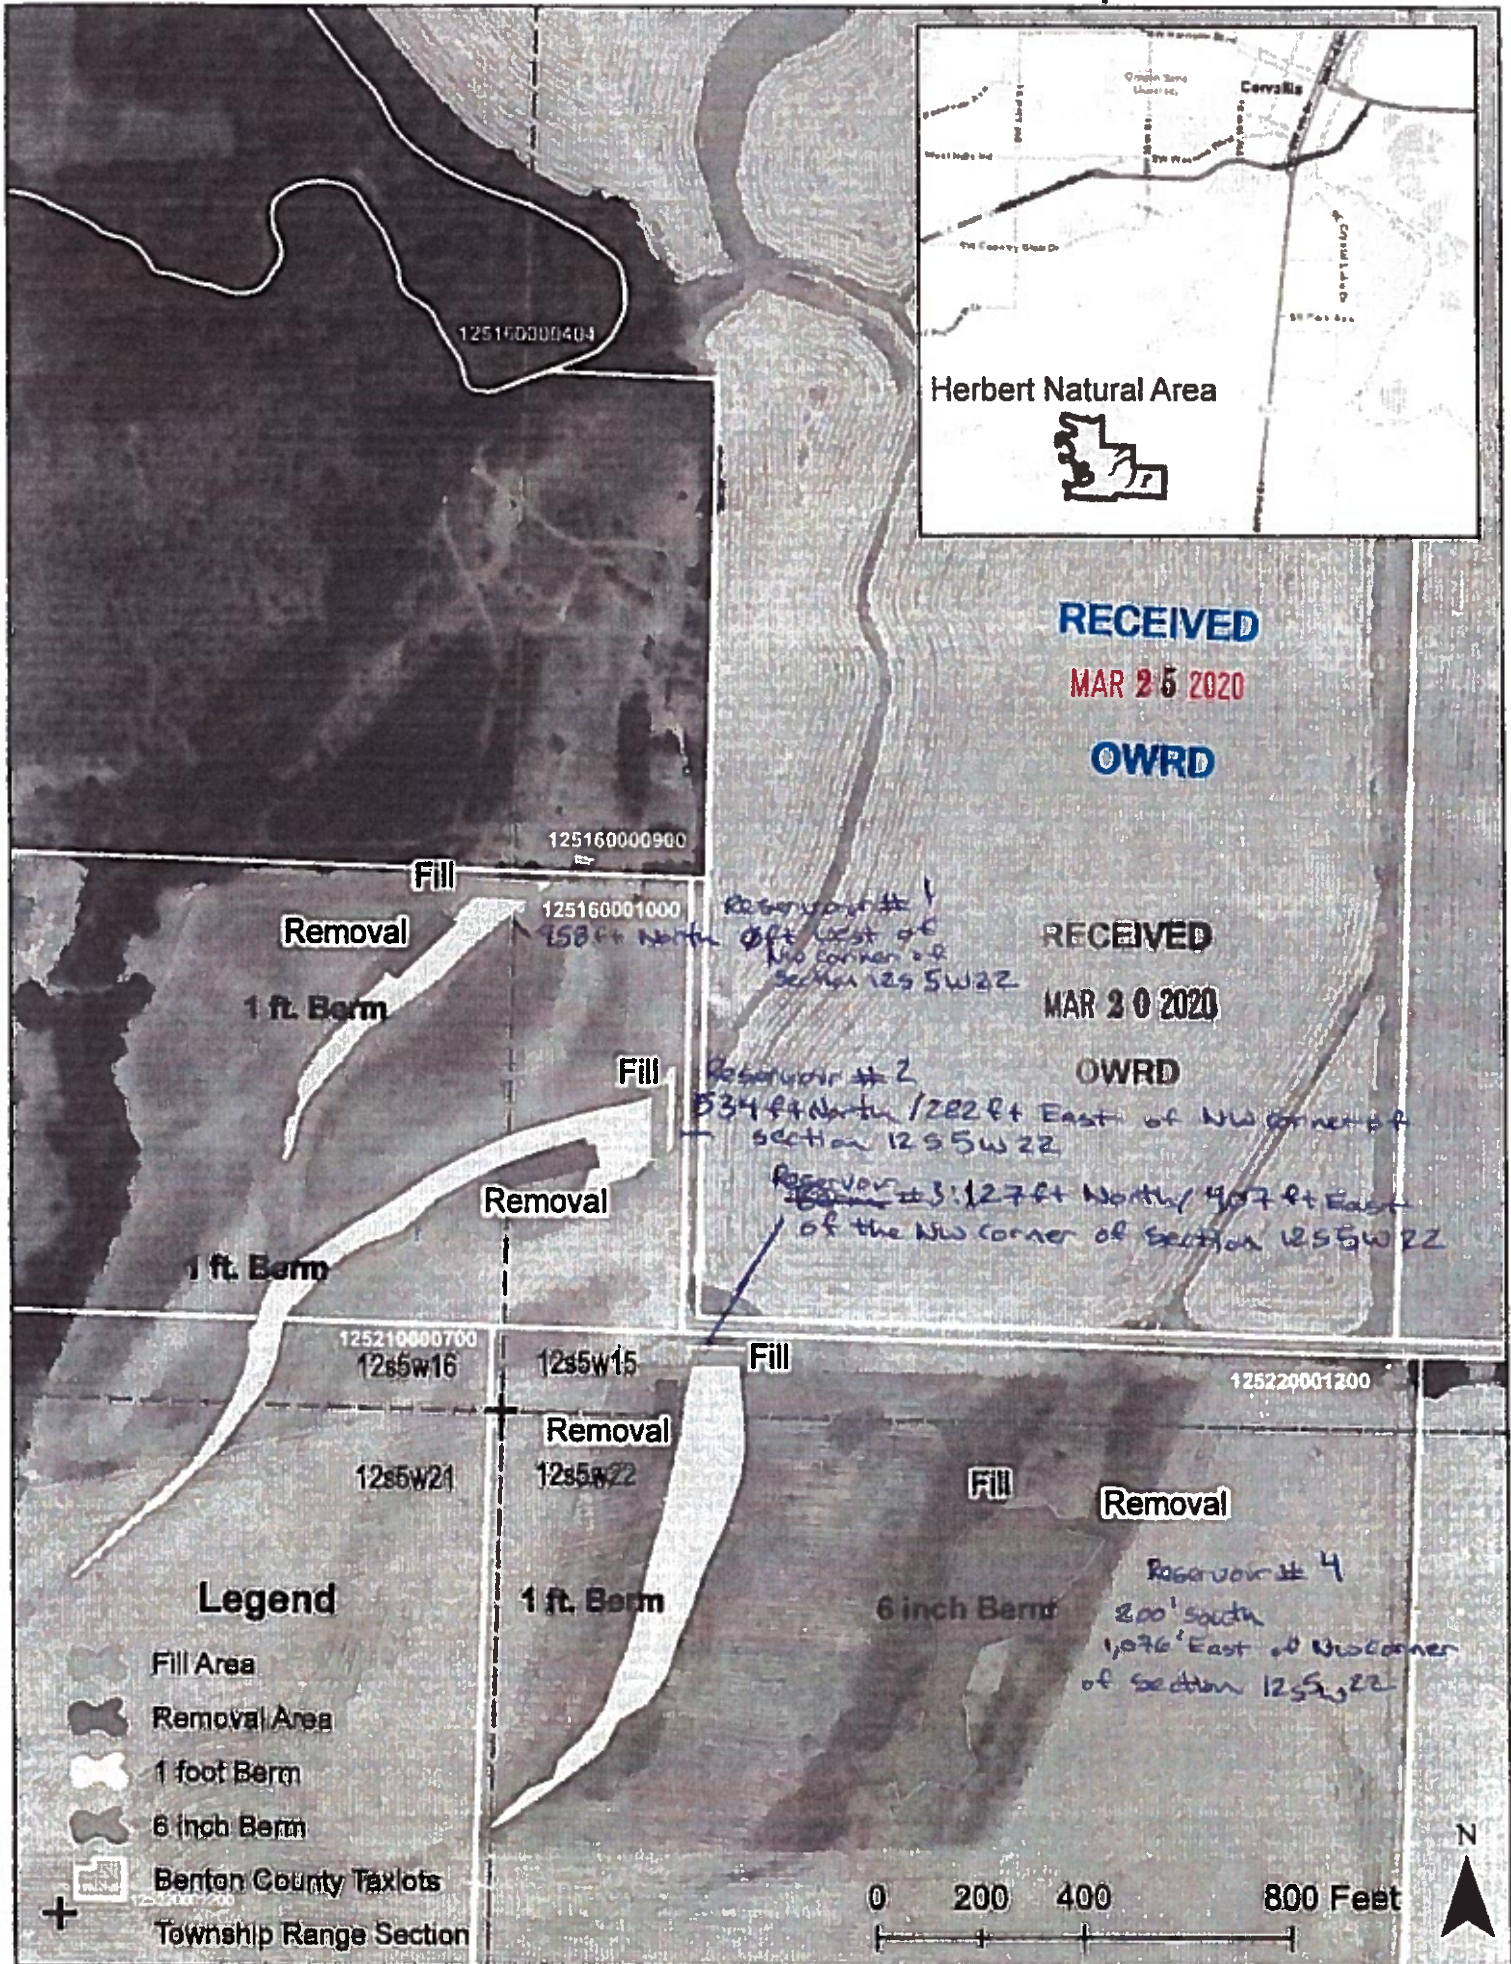


THIS MAP WAS PREPARED FOR ASSESSMENT PURPOSE ONLY

SECTION 16 T.12S. R.5W. W.M.  
BENTON COUNTY  
1" = 400'



12516

REV 12-20-2010  
CANCELLED  
400 THRU 403  
500  
701  
800

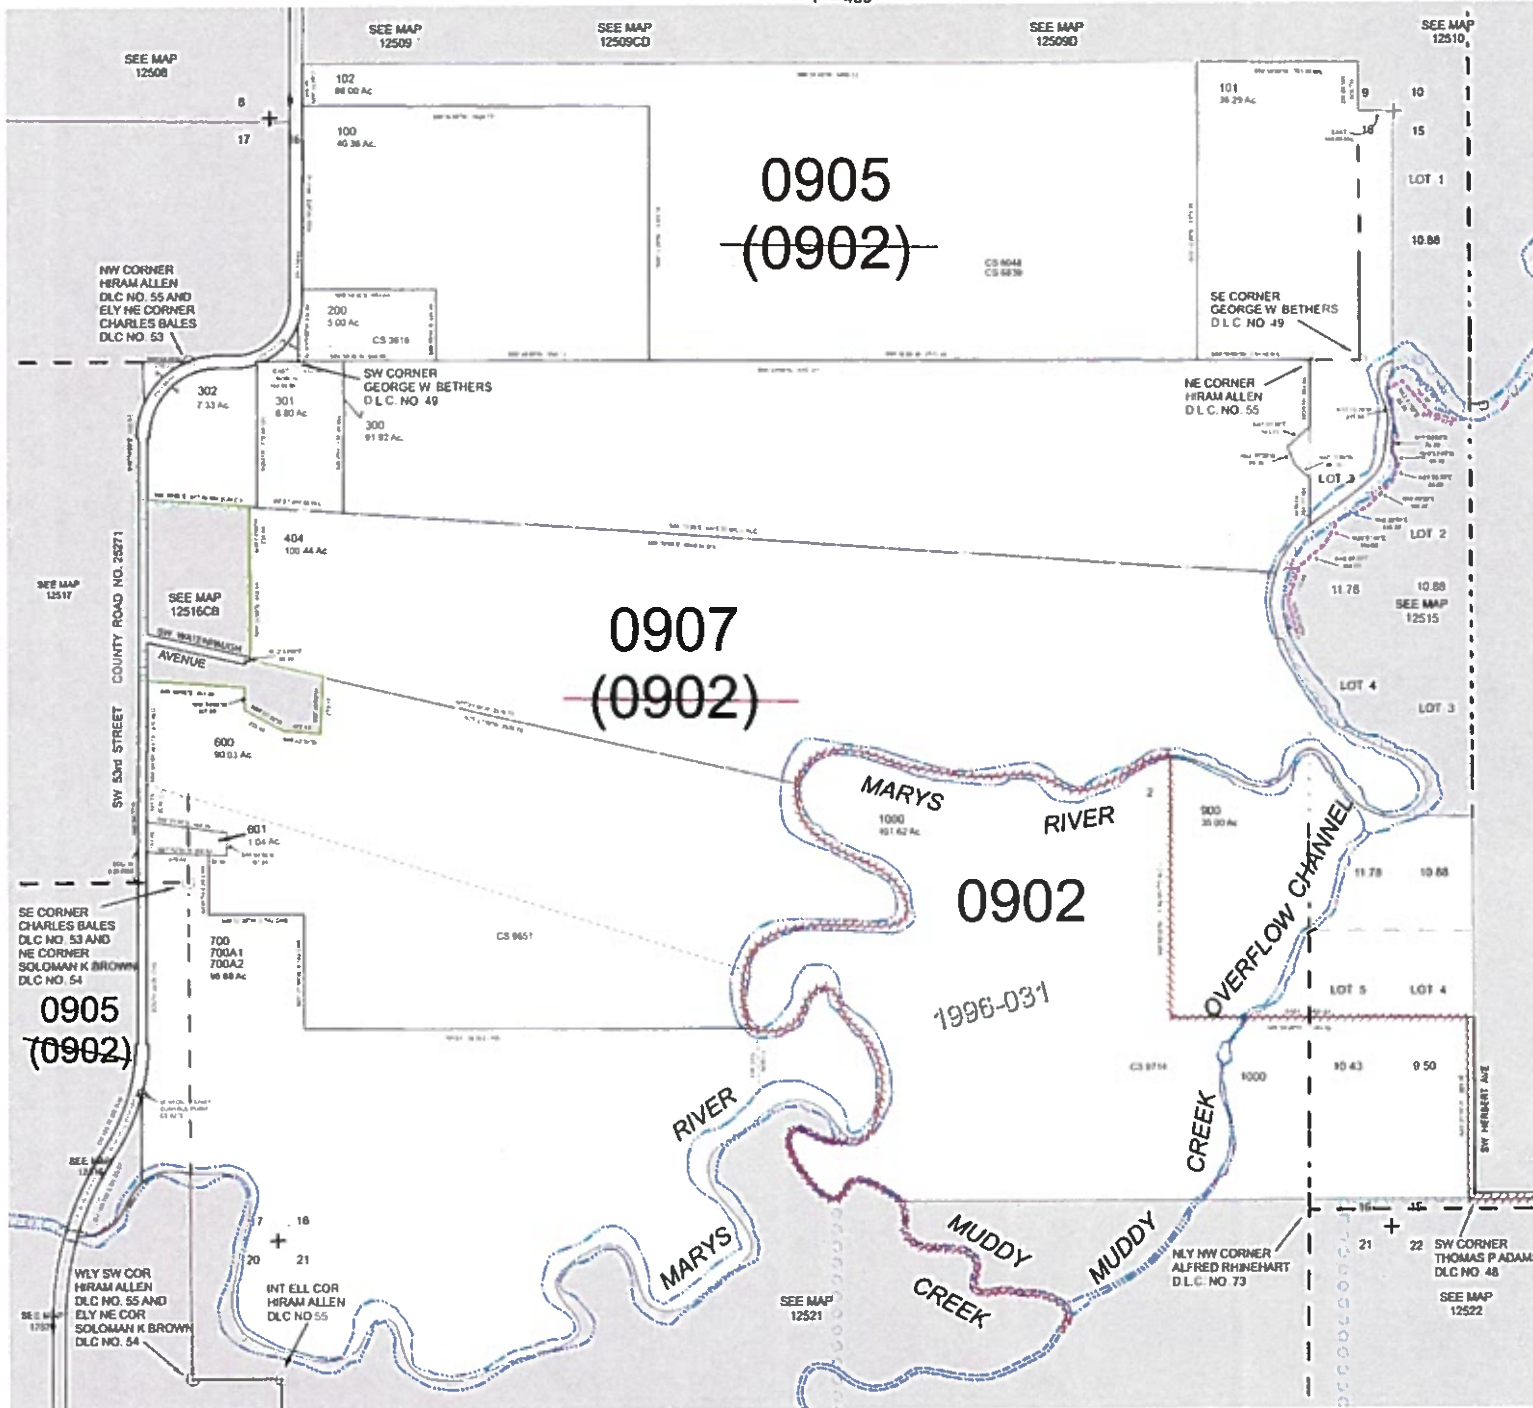


RECEIVED  
MAR 2 0 2020  
OWRD

RECEIVED  
SEP 1 9 2019  
OWRD

12516

9-02)  
9-07

RECEIVED  
MAR 20 2020  
OWRD

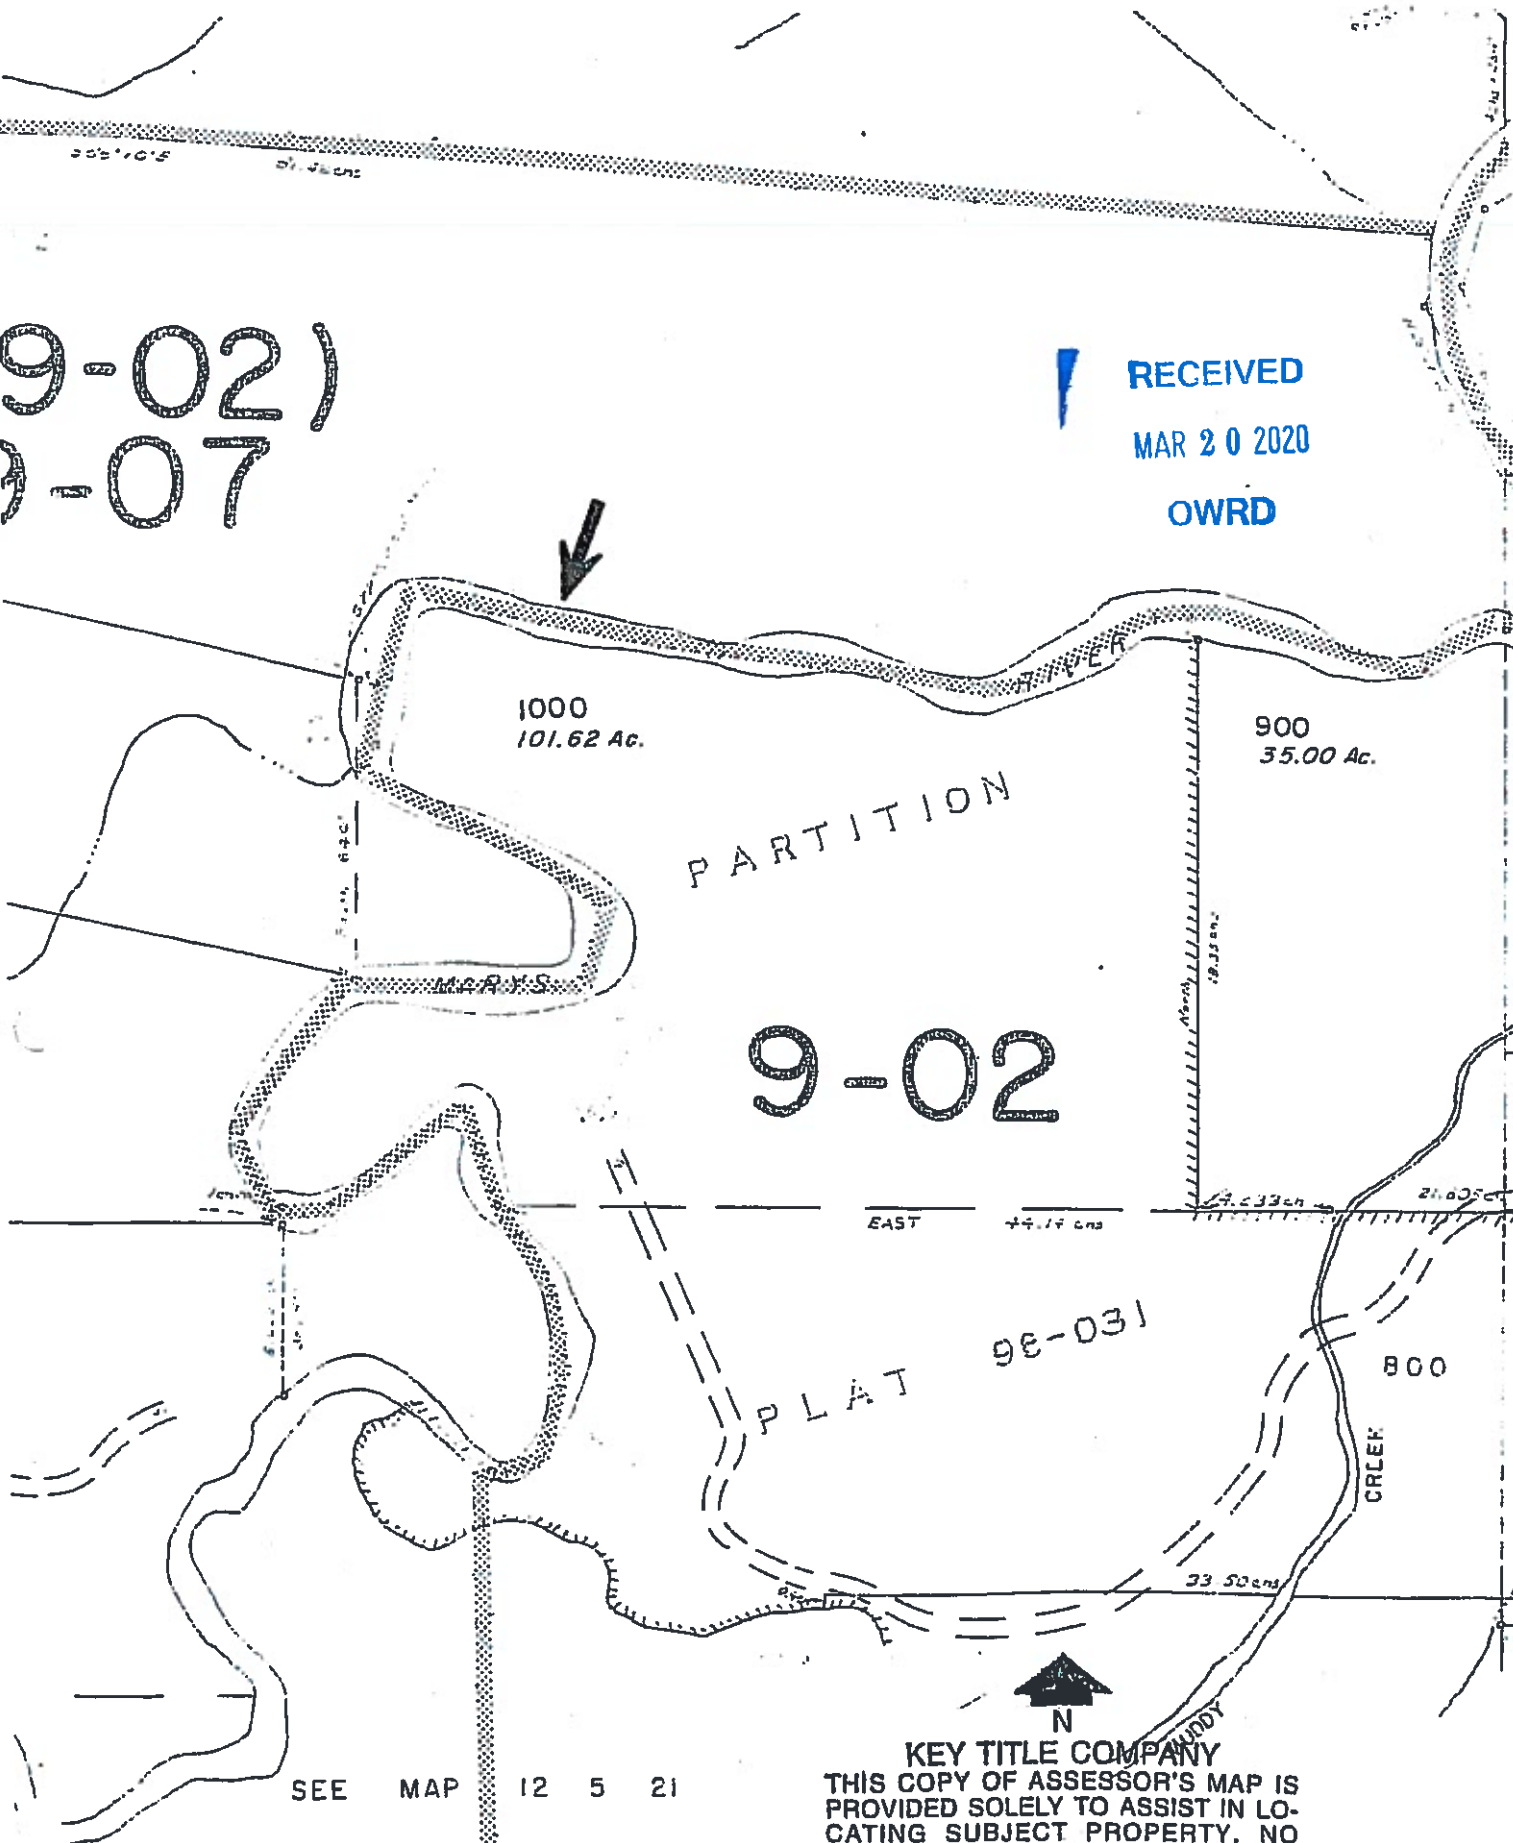

9-02

98-031

SEE MAP 12 5 21

KEY TITLE COMPANY  
THIS COPY OF ASSESSOR'S MAP IS PROVIDED SOLELY TO ASSIST IN LOCATING SUBJECT PROPERTY. NO LIABILITY IS ASSUMED BY KEY FOR DISCREPANCIES IN THIS MAP AS OUTLINED AND THE ACCOMPANYING LEGAL DESCRIPTION.

5W. W.M.

NTY


12 5 21

REV. 03-19-97

CANC.

301  
503  
100

00  
76.03 Ac.

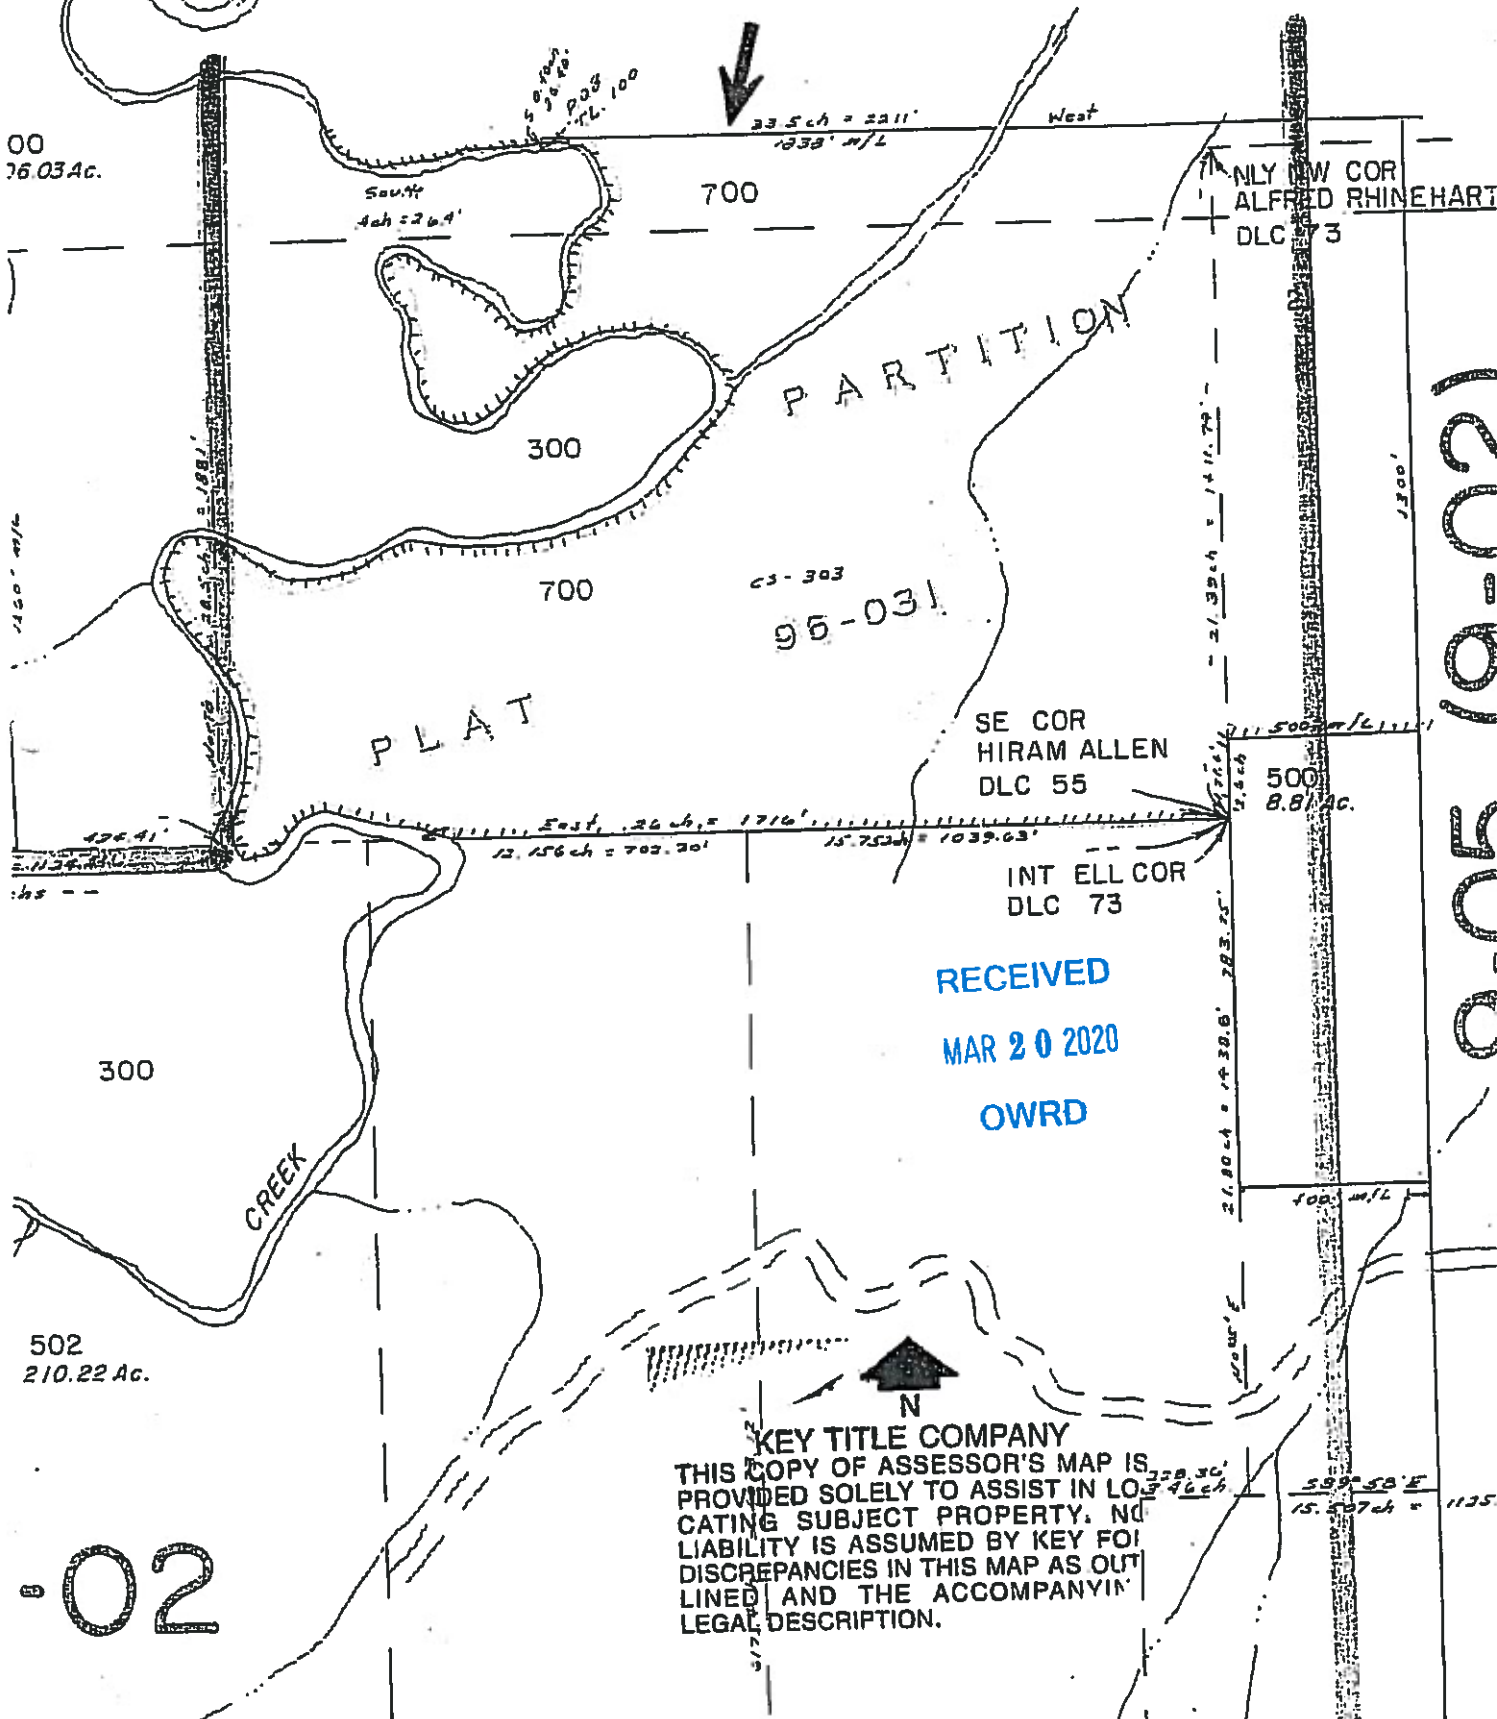

PARTITION

PLAT

RECEIVED  
MAR 20 2020  
OWRD


300

502  
210.22 Ac.

↑ N

KEY TITLE COMPANY  
THIS COPY OF ASSESSOR'S MAP IS  
PROVIDED SOLELY TO ASSIST IN LO-  
CATING SUBJECT PROPERTY. NO  
LIABILITY IS ASSUMED BY KEY FO  
DISCREPANCIES IN THIS MAP AS OUT-  
LINED AND THE ACCOMPANYIN'  
LEGAL DESCRIPTION.


02



**KEY TITLE COMPANY**  
 THIS COPY OF ASSESSOR'S MAP IS PROVIDED SOLELY TO ASSIST IN LOCATING SUBJECT PROPERTY. NO LIABILITY IS ASSUMED BY KEY FOR DISCREPANCIES IN THIS MAP AS OUTLINED AND THE ACCOMPANYING LEGAL DESCRIPTION.

**SEC**

SEE MAP 12

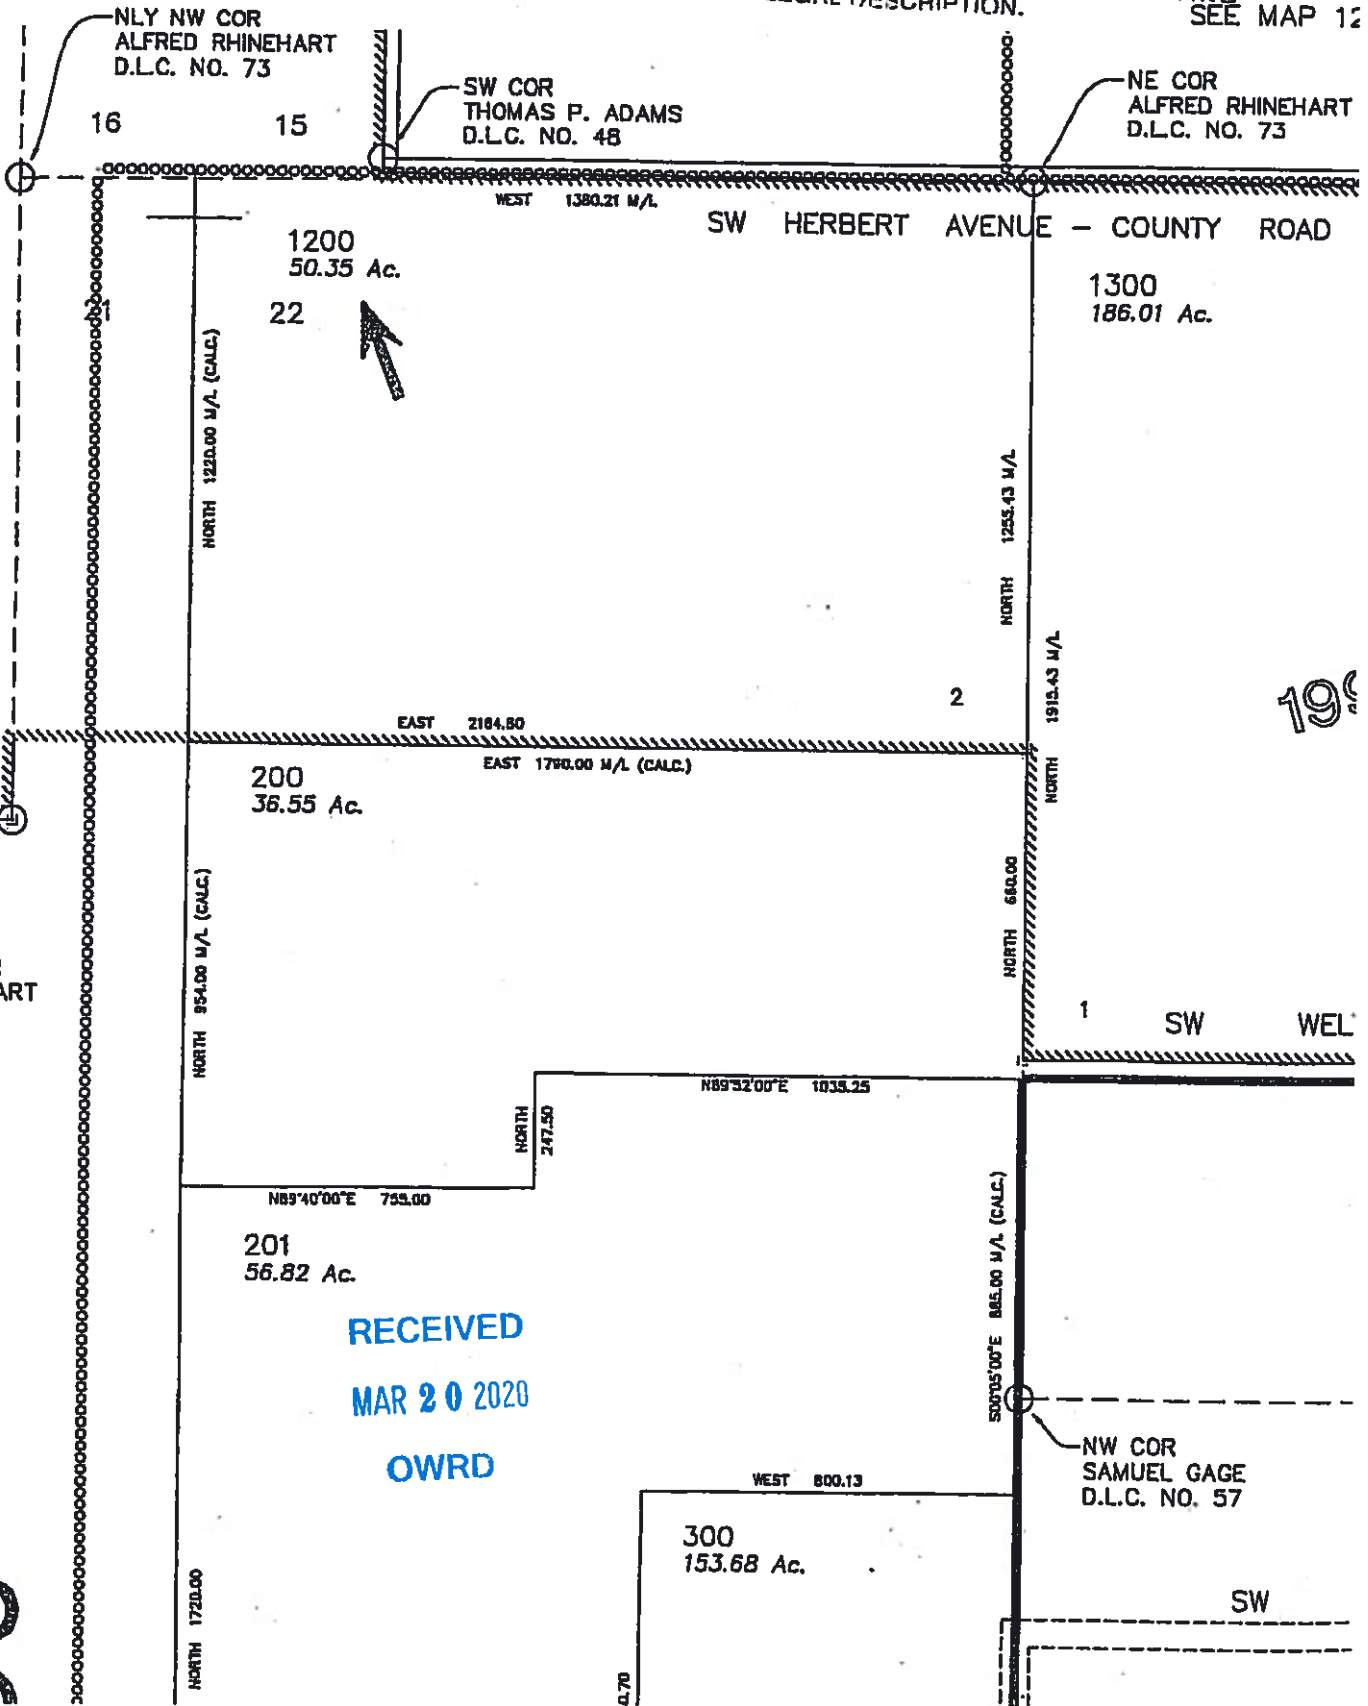

COR AM ALLEN  
 .C. NO. 55

ELL CORNER  
 RED RHINEHART  
 .C. NO. 73

RECEIVED  
 MAR 20 2020  
 OWRD

SEE MAP 12 5 21

30