

APPLICATION MAP

FOR

BRIAN SCALLON

7861 HIGHBANKS ROAD

CENTRAL POINT, OREGON 97502

LOCATED IN THE NORTHEAST QUARTER AND THE SOUTHEAST QUARTER OF THE NORTHEAST QUARTER OF SECTION 21, TOWNSHIP 36 SOUTH, RANGE 2WEST, OF THE WILLAMETTE MERIDIAN, JACKSON COUNTY, OREGON.

RECEIVED

MAY 26 2020

OWRD

NE CORNER DLC 46
SOUTH 773.64'
EAST 454.35'
TO NORTH END DAM

S32°06'02"E TRUE BEARING
S30°25'59"E GRID BEARING
886.54

WETLAND LIMITS

RESERVOIR

WETLAND LIMITS

DAM
9' TALL AT
HIGHEST DOWN
STREAM POINT

ASSESSOR'S MAP & TAX LOT NUMBER

36-2W-21 TL 101

KIRTLAND ROAD

HIGHBANKS ROAD



DATE: 05-06-20

SCALE: 1" = 300'

REGISTERED
PROFESSIONAL
LAND SURVEYOR

OREGON
JULY 12, 2005
FRED A. FRANTZ
No. 50077

Renewal 12-31-21

BASIS OF BEARINGS

GPS OBSERVATION NAD 1983/91 SOUTHERN OREGON SOUTH ZONE
AT THE NORTHEAST CORNER OF DLC 46.

TERRASURVEY, INC.

PROFESSIONAL LAND SURVEYORS


274 FOURTH STREET
ASHLAND, OREGON 97520

(541) 482-6474

terrain@bisp.net

JOB NO. 1242-19

If the diversion involves a dam, use this space for sketches of the diversion (e.g. cross-section of the dam with its dimensions, dimension and placement of outlet pipe, means of passing live flow outside of the authorized storage season, and means for providing fish passage).

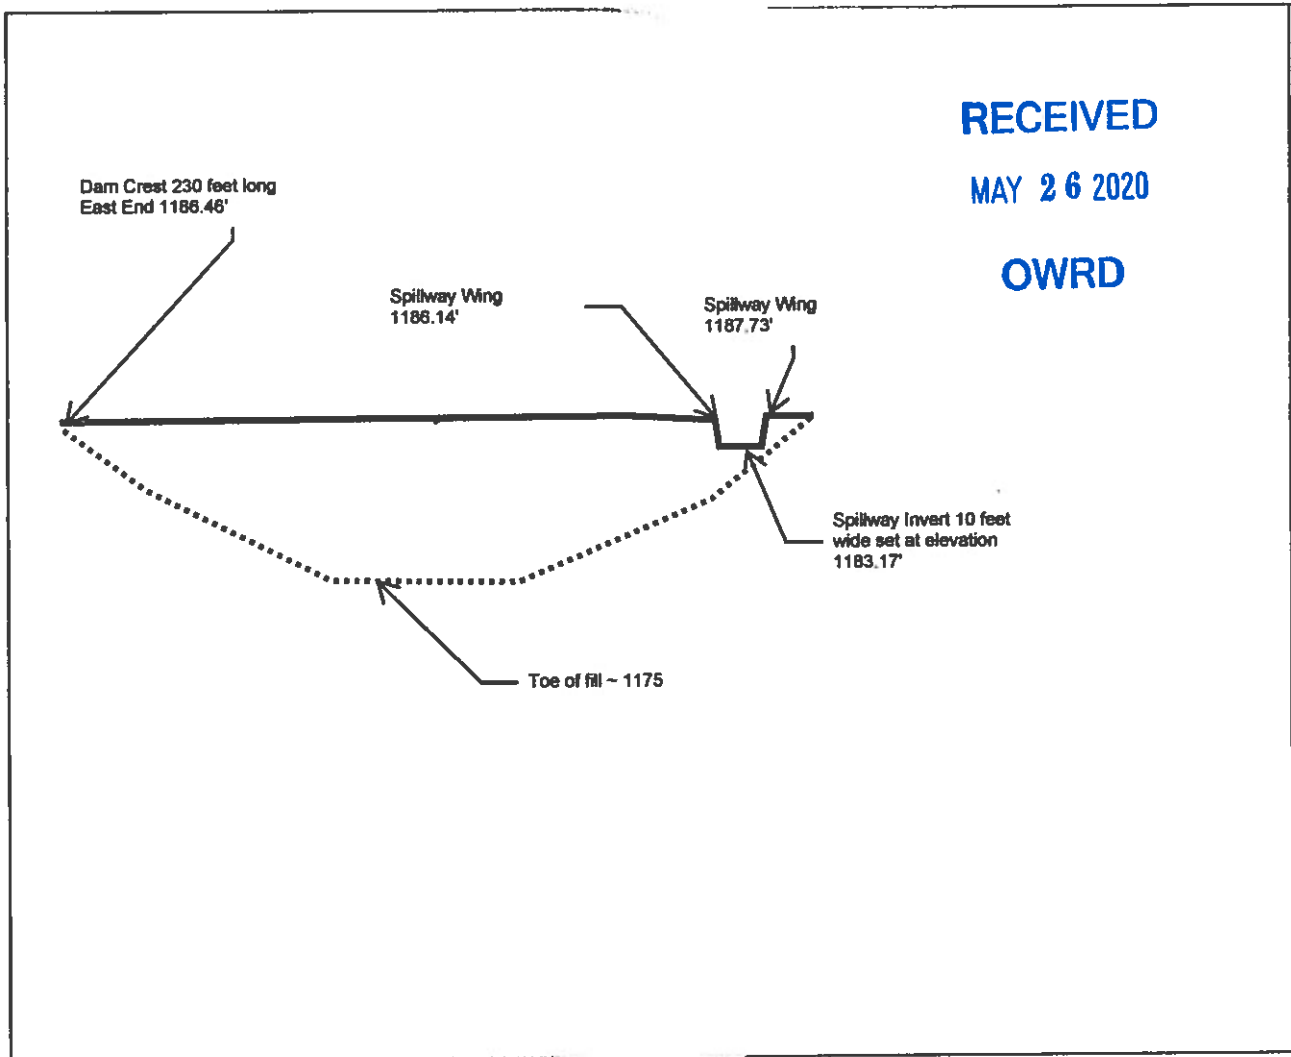

9. SIGNATURE

I swear that all statements made and information provided in this application are true and correct to the best of my knowledge.

Brian Sullivan
Applicant Signature

5/11/2020
Date

- Before you submit your application be sure you have:**
- Answered each question completely.
 - Included a legible map that includes Township, Range, Section, quarter-quarter and tax lot number.
 - The map must meet map requirements to be accepted.
 - Included a land use form or receipt stub signed by a local planning official.
 - Included a check payable to Oregon Water Resources Department for the appropriate amount.