

RECEIVED

MAY 05 2022

OWRD

Curry County Web Map

RECEIVED RECEIVED

MAR 25 2022

MAR 25 2022


OWRD

OWRD



1/4/2022, 4:29:41 PM

- | | | | | | | |
|------------------------------|-------------------------|-------------------------------|---------------|--------|---------|-----------|
| World Imagery | Highways (1) | Urban Growth Boundary | V | FG | R-3 | RI |
| Low Resolution 15m Imagery | All Roads | Counties | VE | I | RC | RR-10 |
| High Resolution 60cm Imagery | Parcels | Streams | County Zoning | MA | RC-10 | RR-5 |
| High Resolution 30cm Imagery | Parcel Labels | Wetlands (NWI) | AFD | MPA/FG | RCR-1 | RRC |
| Citations | Situs Address (Current) | Rapidly Moving Slides Central | C-1 | PF | RCR-10 | SW |
| 1.2m Resolution Metadata | Townships | Flood Hazard (updated) | C-2 | R-1 | RCR-2.5 | T |
| Override 1 | City Limits | A | CON | R-2 | RCR-5 | NOT ZONED |
| | | AE | EFU | | | |

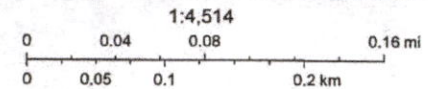

Bureau of Land Management, State of Oregon, State of Oregon DOT, State of Oregon GEO, Esri Canada, Esri, HERE, Garmin, USGS, EPA, USDA, Maxar

Created by LCOG for Curry County

The information on this map was derived from digital databases from the Curry County regional geographic information system by LCOG. Care was taken in the creation of this map, but is provided "as-is". Curry County and LCOG cannot accept any responsibility for errors, omissions or positional accuracy in the digital

Curry County Web Map


OWRD

OWRD



1/4/2022, 4:28:04 PM

- World Imagery
- Low Resolution 15m Imagery
- High Resolution 60cm Imagery
- High Resolution 30cm Imagery
- Citations
- 1.2m Resolution Metadata
- Override 1
- MapTaxLot Cards South
- Current
- History
- Highways (1)
- All Roads
- Parcels
- Parcel Labels
- Situs Address (Current)
- Townships
- City Limits
- Urban Growth Boundary
- Counties
- Streams
- Wetlands (NWI)
- Rapidly Moving Slides South
- Flood Hazard (updated)
- A
- AE
- V
- VE

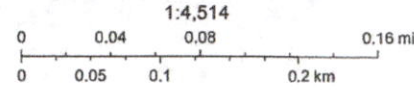

Bureau of Land Management, State of Oregon, State of Oregon DOT, State of Oregon GEO, Esri Canada, Esri, HERE, Garmin, USGS, EPA, USDA, Maxar

The information on this map was derived from digital databases from the Curry County regional geographic information system by LCOG. Care was taken in the creation of this map, but is provided "as-is". Curry County and LCOG cannot accept any responsibility for errors, omissions or positional accuracy in the digital

LOT 1
39.90

2009-13

RECEIVED

MAY 05 2022

RECEIVED

MAR 25 2022 25 2022

OWRD OWRD

OWRD


*pond site
tax lot # 36-14-12-311


RECEIVED

MAY 05 2022

OWRD

Lou Phelan
M. Phelan

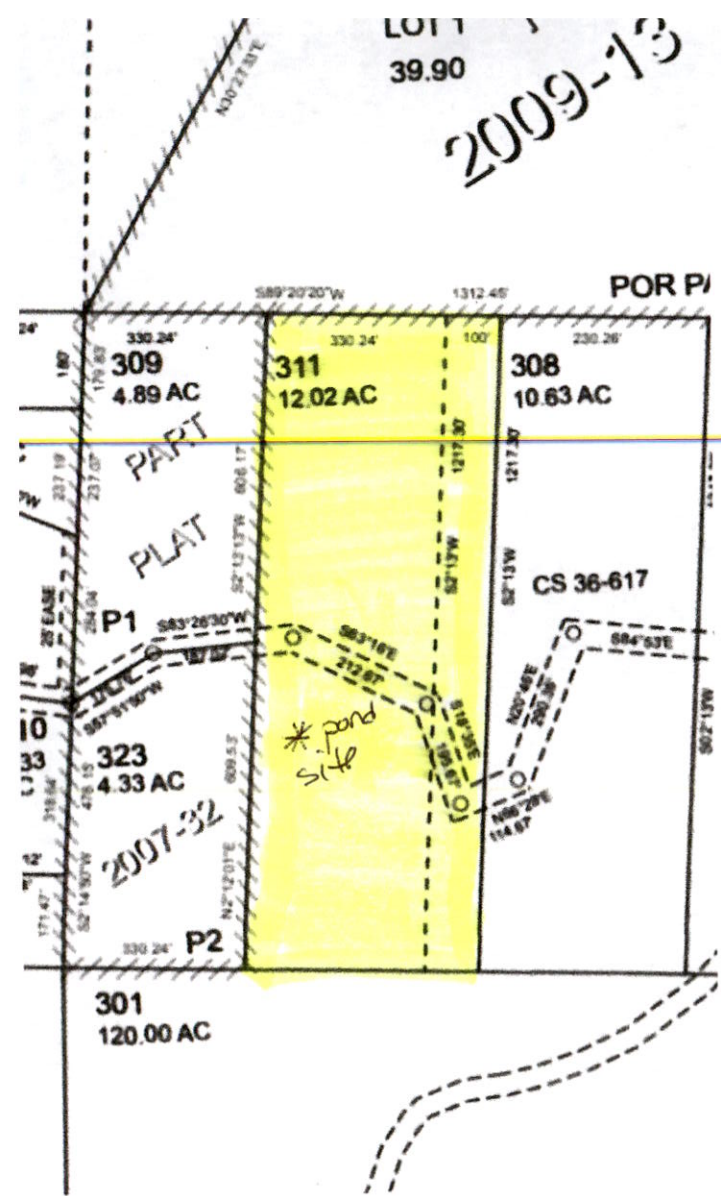

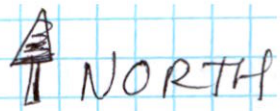

RECEIVED

MAY 05 2022

OWRD

Mark + Lori
Phelan
97332 Homestead
way
Gold Beach, Ore
97444
541-247-6601

tax Lot: 36-14-
12-311

Section 12
township 36, south
Range 14, west
Willamette meridian
Curry Co, Oregon
Quarter-Quarter.
SWNE

Scale:
1" = 100'

