


SITE PLAN SUBMITTAL FORM

OWNER NAME: Susan Lorincz	Map and Taxlot #: 18-03-09-5700	APPLICANT NAME: _____
PHONE # 515-5770	_____	PHONE # _____
ADDRESS: 2899 E 40TH EUGENE OREGON	Scale: 1" = 60' (11" x 17")	ADDRESS: _____


T18S R03W SECTION 09

LMD staff can NOT be held responsible for evaluations based on false, inaccurate or incomplete information


BP# 09-0247
 PLANNING SETBACKS O.K.
 DATE 3/24/09
 INITIALS SYE

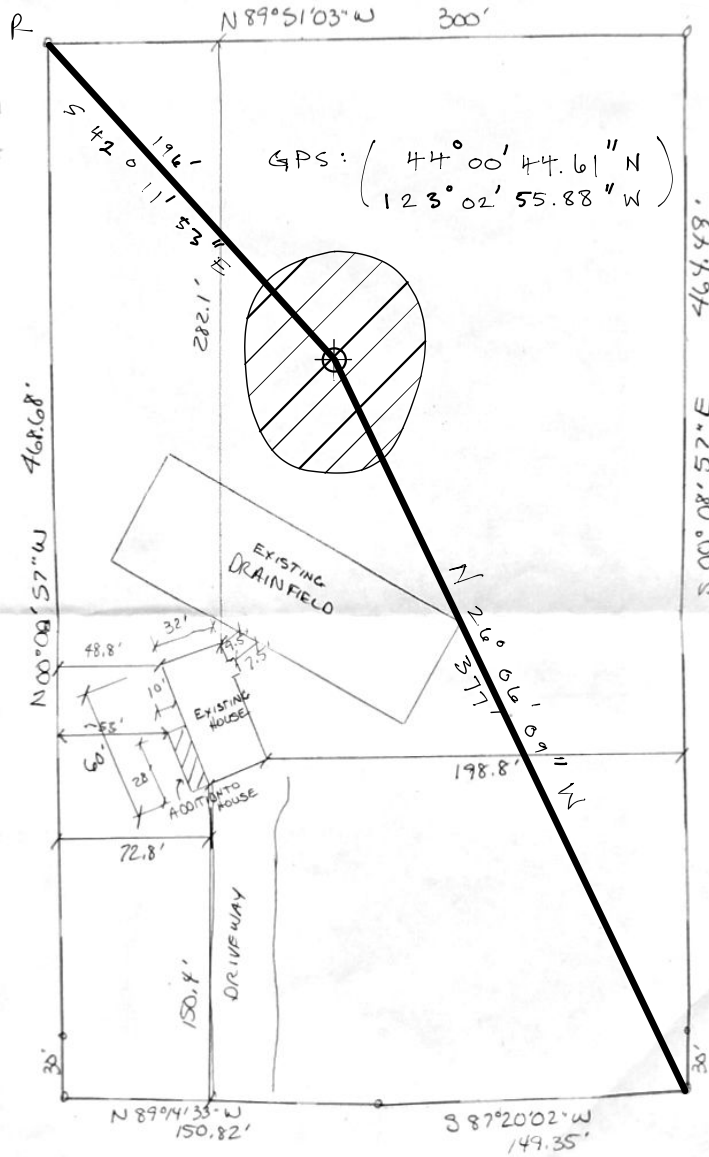

OVERVIEW

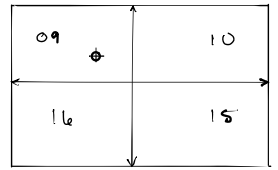

* NOT TO SCALE *

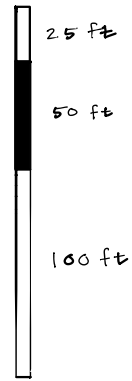

3.27 ACRES

E. 40TH AVE

- CENTER OF EXISTING RESERVOIR IS 133' E AND 146' S OF REF. CORNER (NW) DENOTED R.
- POND IS FED BY GROUNDWATER AND RUNOFF. NO STREAM, DIVERSION OR DAM PRESENT.
- GPS LOCATION IS 415' N AND 435' W FROM PLSS CORNER OF SECTIONS 09, 10, 15, AND 16 (SEE OVERVIEW).