

THIS MAP WAS PREPARED FOR ASSESSMENT PURPOSE ONLY


0 100 200 400 Feet

SECTION 3 T.7N. R.4W. W.M.

07 04 03 00

COLUMBIA COUNTY

1" = 400'

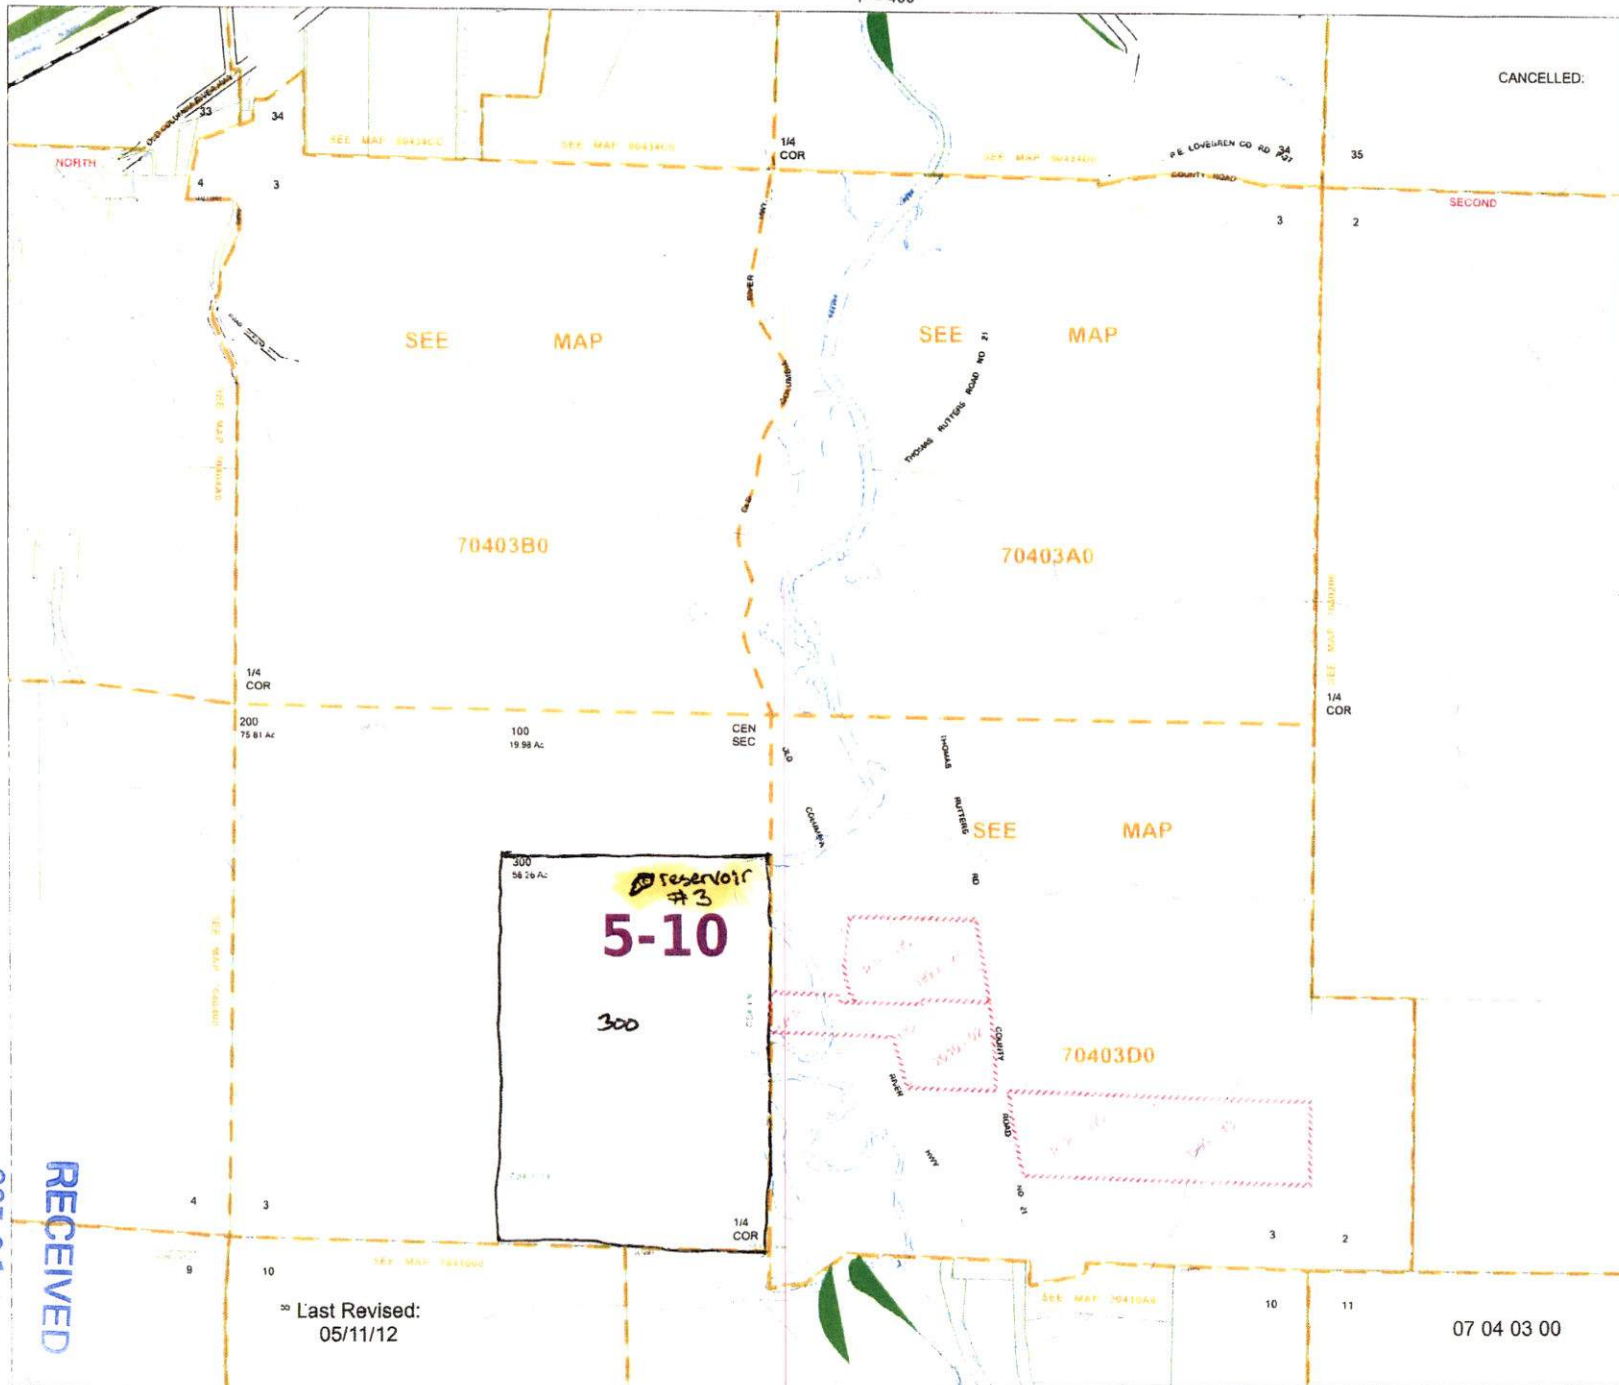

CANCELLED:



Dam location
 3,015' west
 and 1,828' north
 of the SE
 corner of
 section 3

Last Revised:
 05/11/12

07 04 03 00

RECEIVED
 OCT 21 2021
 OWRD

RECEIVED
 JUN 17 2019
 OWRD