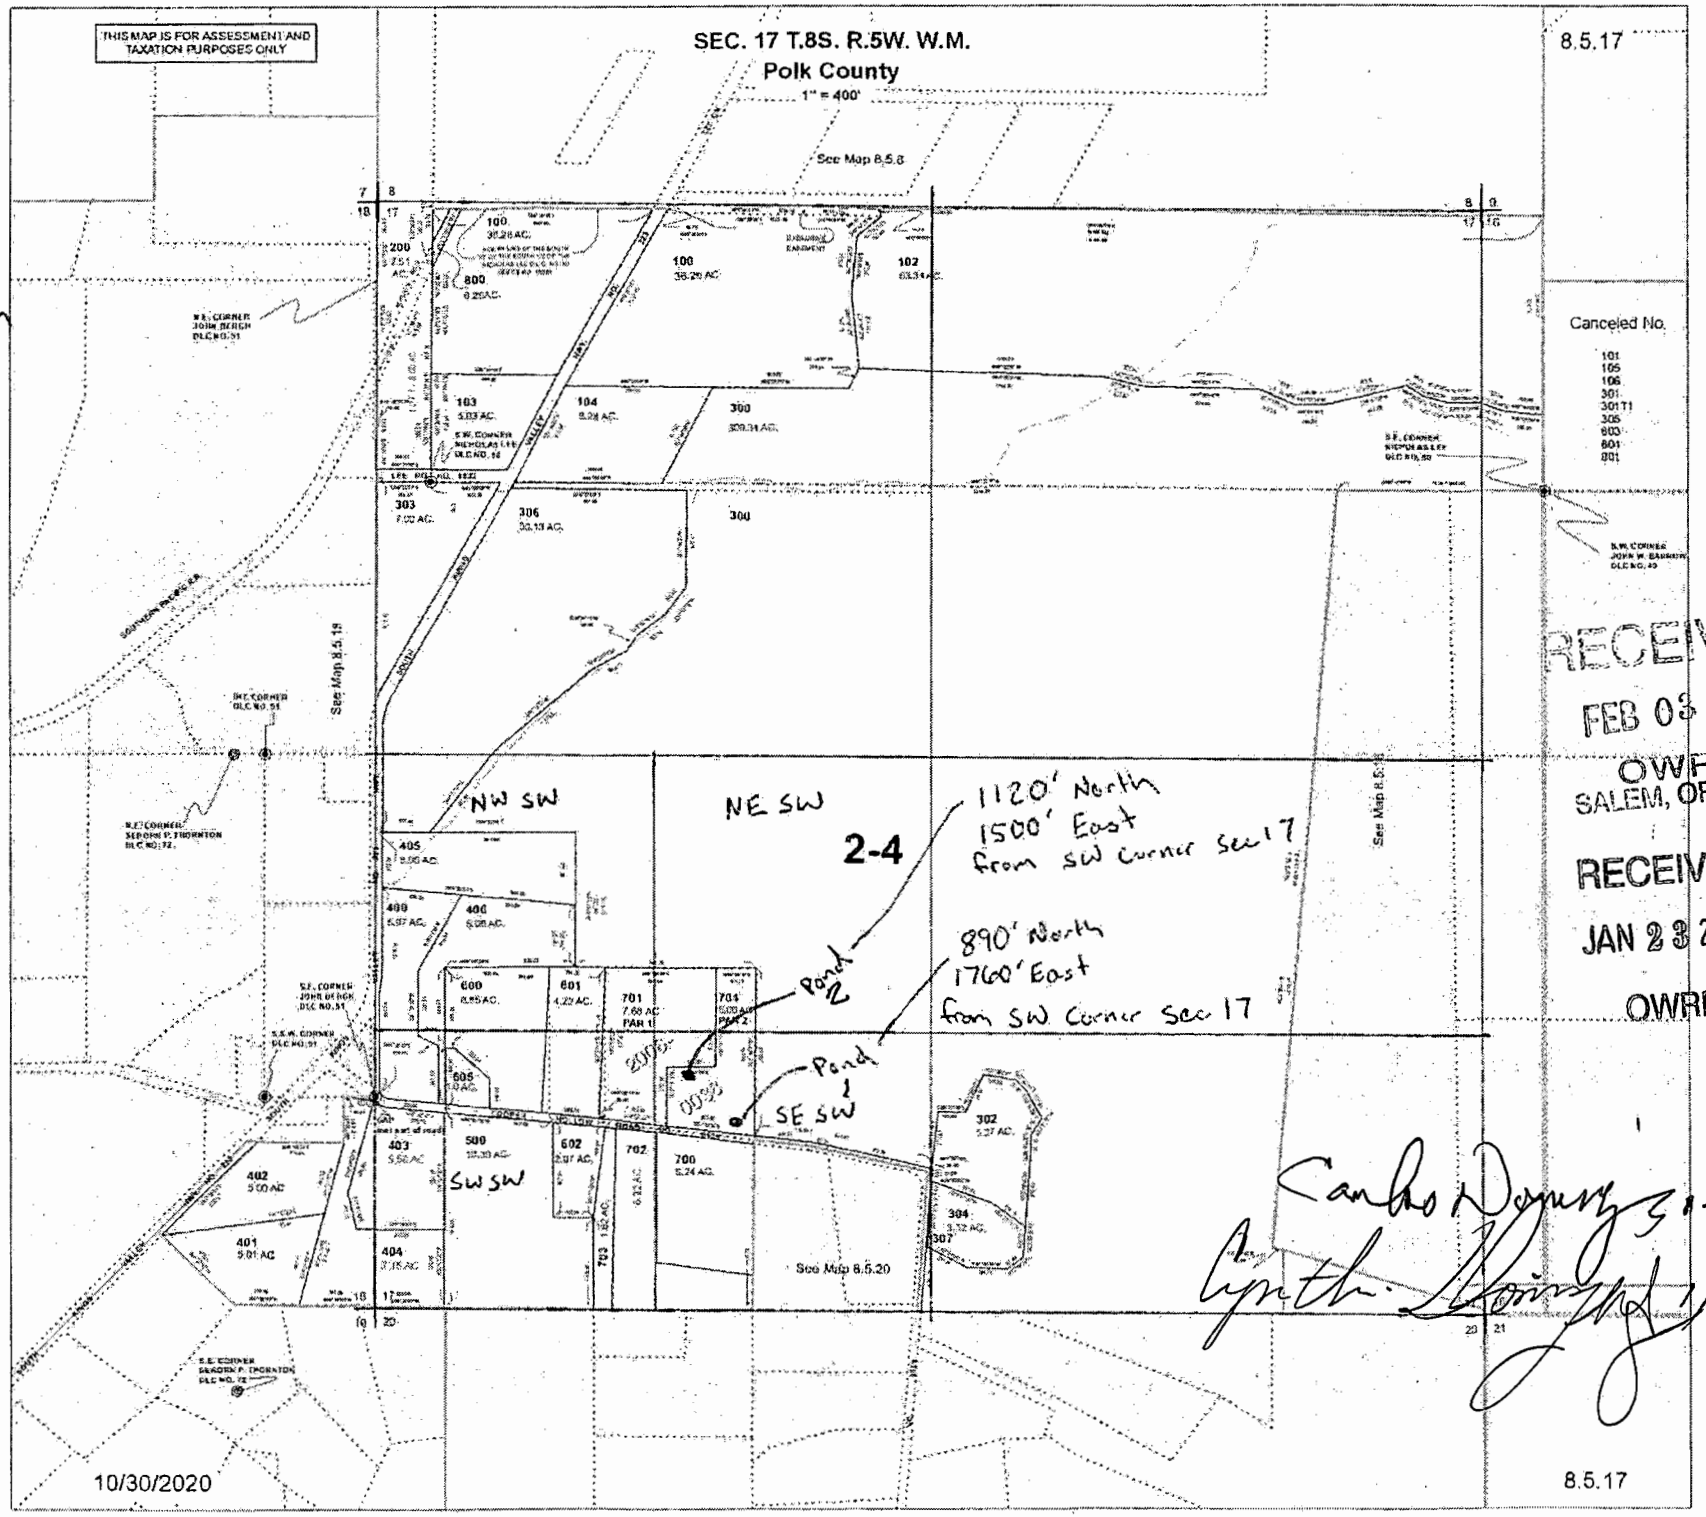
THIS MAP IS FOR ASSESSMENT AND TAXATION PURPOSES ONLY
SEC. 17 T.8S. R.5W. W.M.
Polk County
1" = 400'
8.5.17
North
See Map 8.5.8
See Map 8.5.19
See Map 8.5.20
Canceled No.
101
105
106
301
301 T1
305
600
601
801
NW SW
NE SW
SW SW
SE SW
2-4
1120' North
1500' East
from SW Corner Sec 17
890' North
1760' East
from SW Corner Sec 17
Pond 2
Pond 1
RECEIVED
FEB 08 2023
OWRD
SALEM, OREGON
RECEIVED
JAN 23 2023
OWRD
Cambo Downey 1-19-2023
Cynthia Thompson 1/19/202
10/30/2020
8.5.17