


QT/QT=SWSW

MAP TAX LOT: 35S, 06W, 05-00-001300-00

LAT/LONG: 42.550349, -123.445026


3434 QUARTZ CREEK RD. MERLIN OR 97532

266.4 FEET NORTH AND 108.4 FEET EAST FROM THE SW CORNER OF SECTION 5

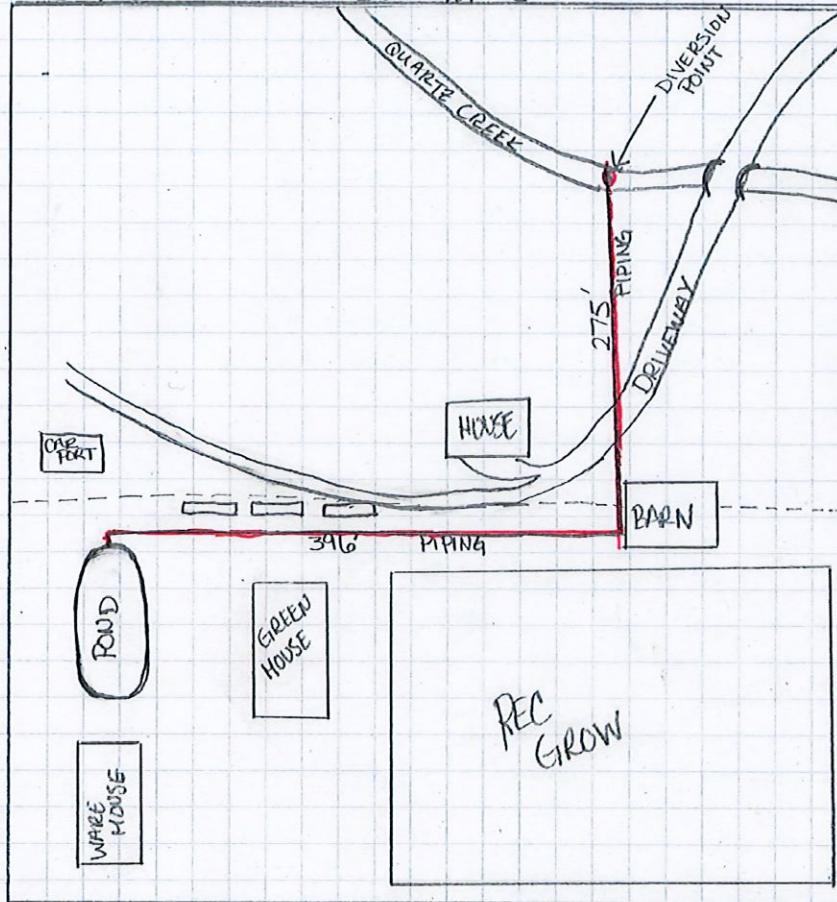

RECEIVED  
APR 06 2023  
OWRD

POND  
CAPACITY:  
0.918 AF

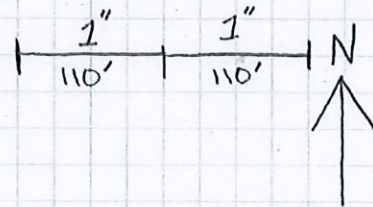

## **DIVERSION LOCATION FROM LAND SURVEY CORNER**

490 FEET NORTH AND 568 FEET EAST FROM THE SW CORNER OF THE  
SOUTHWEST QUARTER OF THE SOUTHWEST QUARTER OF SECTION 5, TOWNSHIP  
35 SOUTH, RANGE 6 WEST OF THE WILLAMETTE MERIDIAN, JOSEPHINE COUNTY,  
OREGON.

### **LATITUDE AND LONGITUDE:**

42.551086, -123.4435

**POND LOCATION FROM LAND SURVEY CORNER**

266.4 FEET NORTH AND 108.4 FEET EAST FROM THE SW CORNER OF THE  
SOUTHWEST QUARTER OF THE SOUTHWEST QUARTER OF SECTION 5, TOWNSHIP  
35 SOUTH, RANGE 6 WEST OF THE WILLAMETTE MERIDIAN, JOSEPHINE COUNTY,  
OREGON.

LATITUDE AND LONGITUDE TO CENTER OF POND:

42.550349, -123.445026

RECEIVED

APR 06 2023

OWRD