


E-RECEIVED  
 NOV 30 2023  
 OWRD

NWNW CORNER  
 OF 9.5. 13  $\frac{11}{14} \frac{12}{13}$

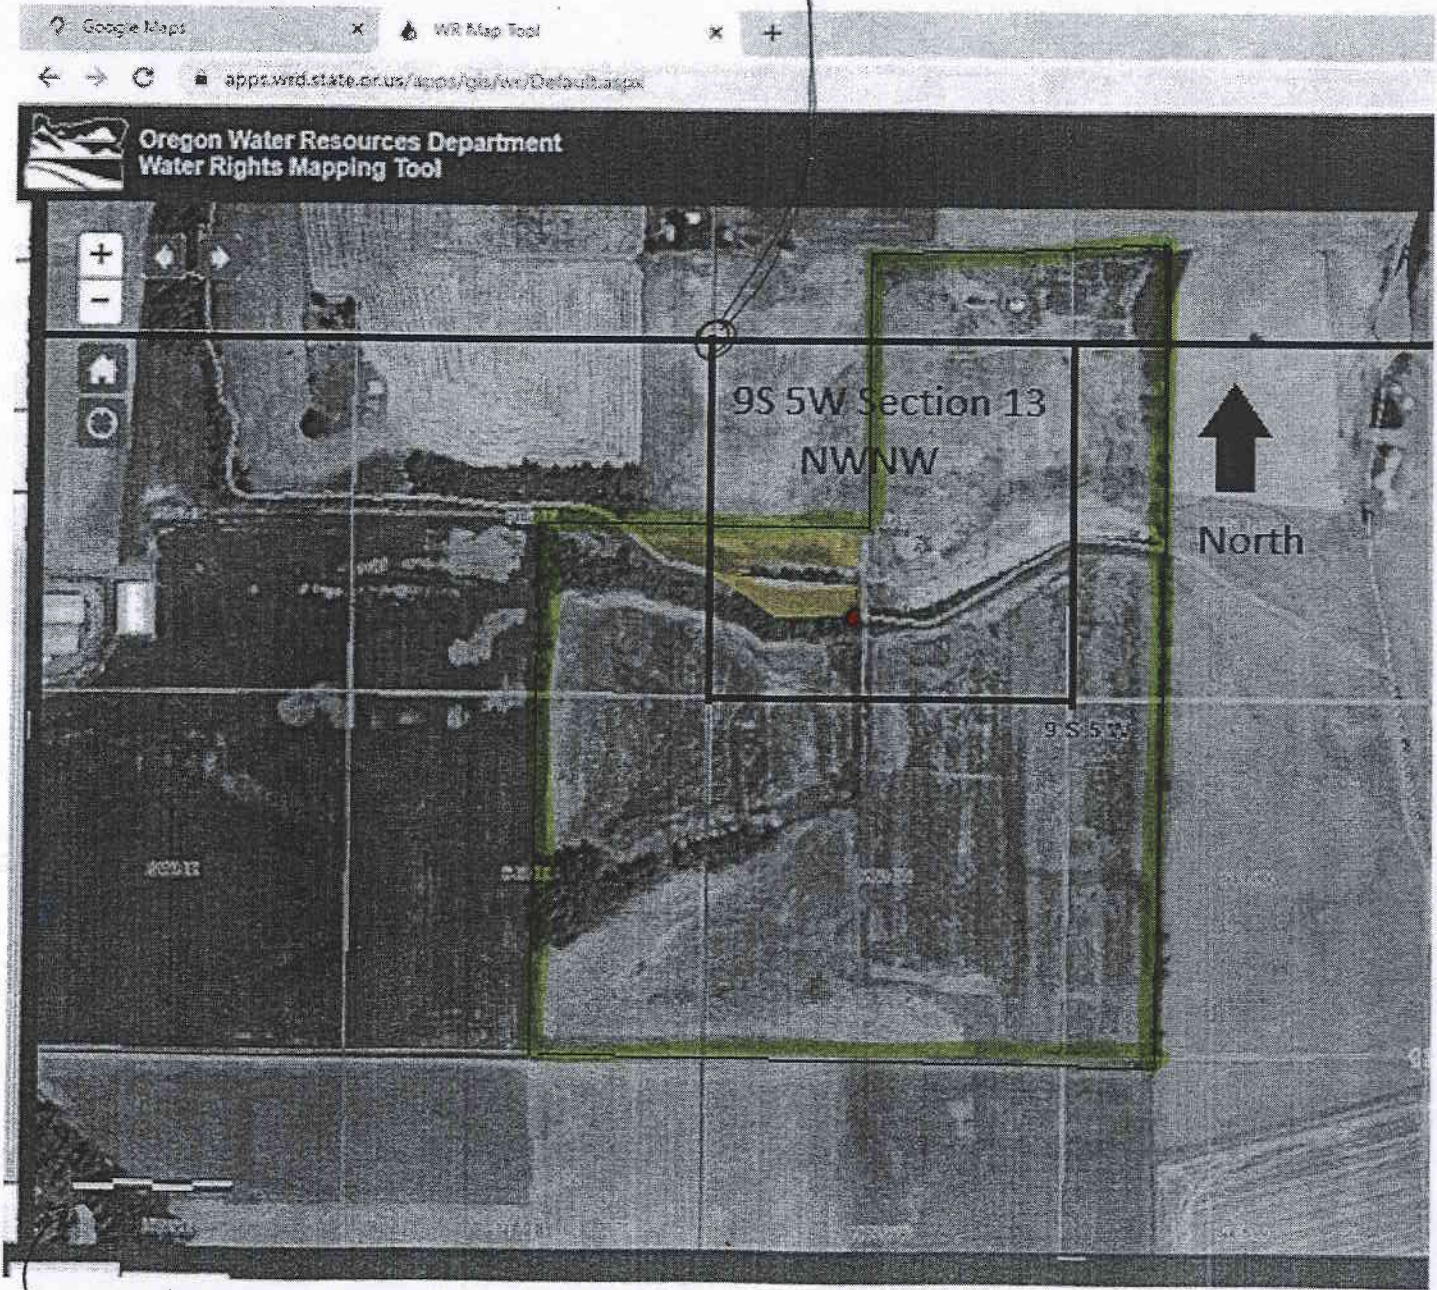

- RESERVOIR
- TAX LOT 100 BOUNDARY
- DAM POINT OF DIVERSION/  
 COLVERT/OUTLET  
 LOCATED 1000 FT SOUTH  
 546 FT EAST  
 FROM NWNW CORNER  
 OF 9S5W SECTION 13
- PUMP LOCATED ON DAM -  
 INTAKE MAY BE UP TO 10 FEET  
 SOUTH

600 FT SCALE


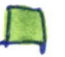





NWNW CORNER  
OF 9.5. 13

11	12
14	13



-  RESERVOIR
-  TAX LOT 100 BOUNDARY
-  POINT OF DIVERSION/  
DAM CONVECT/OULETS  
LOCATED 1000 FT SOUTH  
546 FT EAST  
FROM NWNW CORNER  
OF 9S5W SECTION 13

RECEIVED  
AUG 07 2023  
OWRD