


Reservoir Map

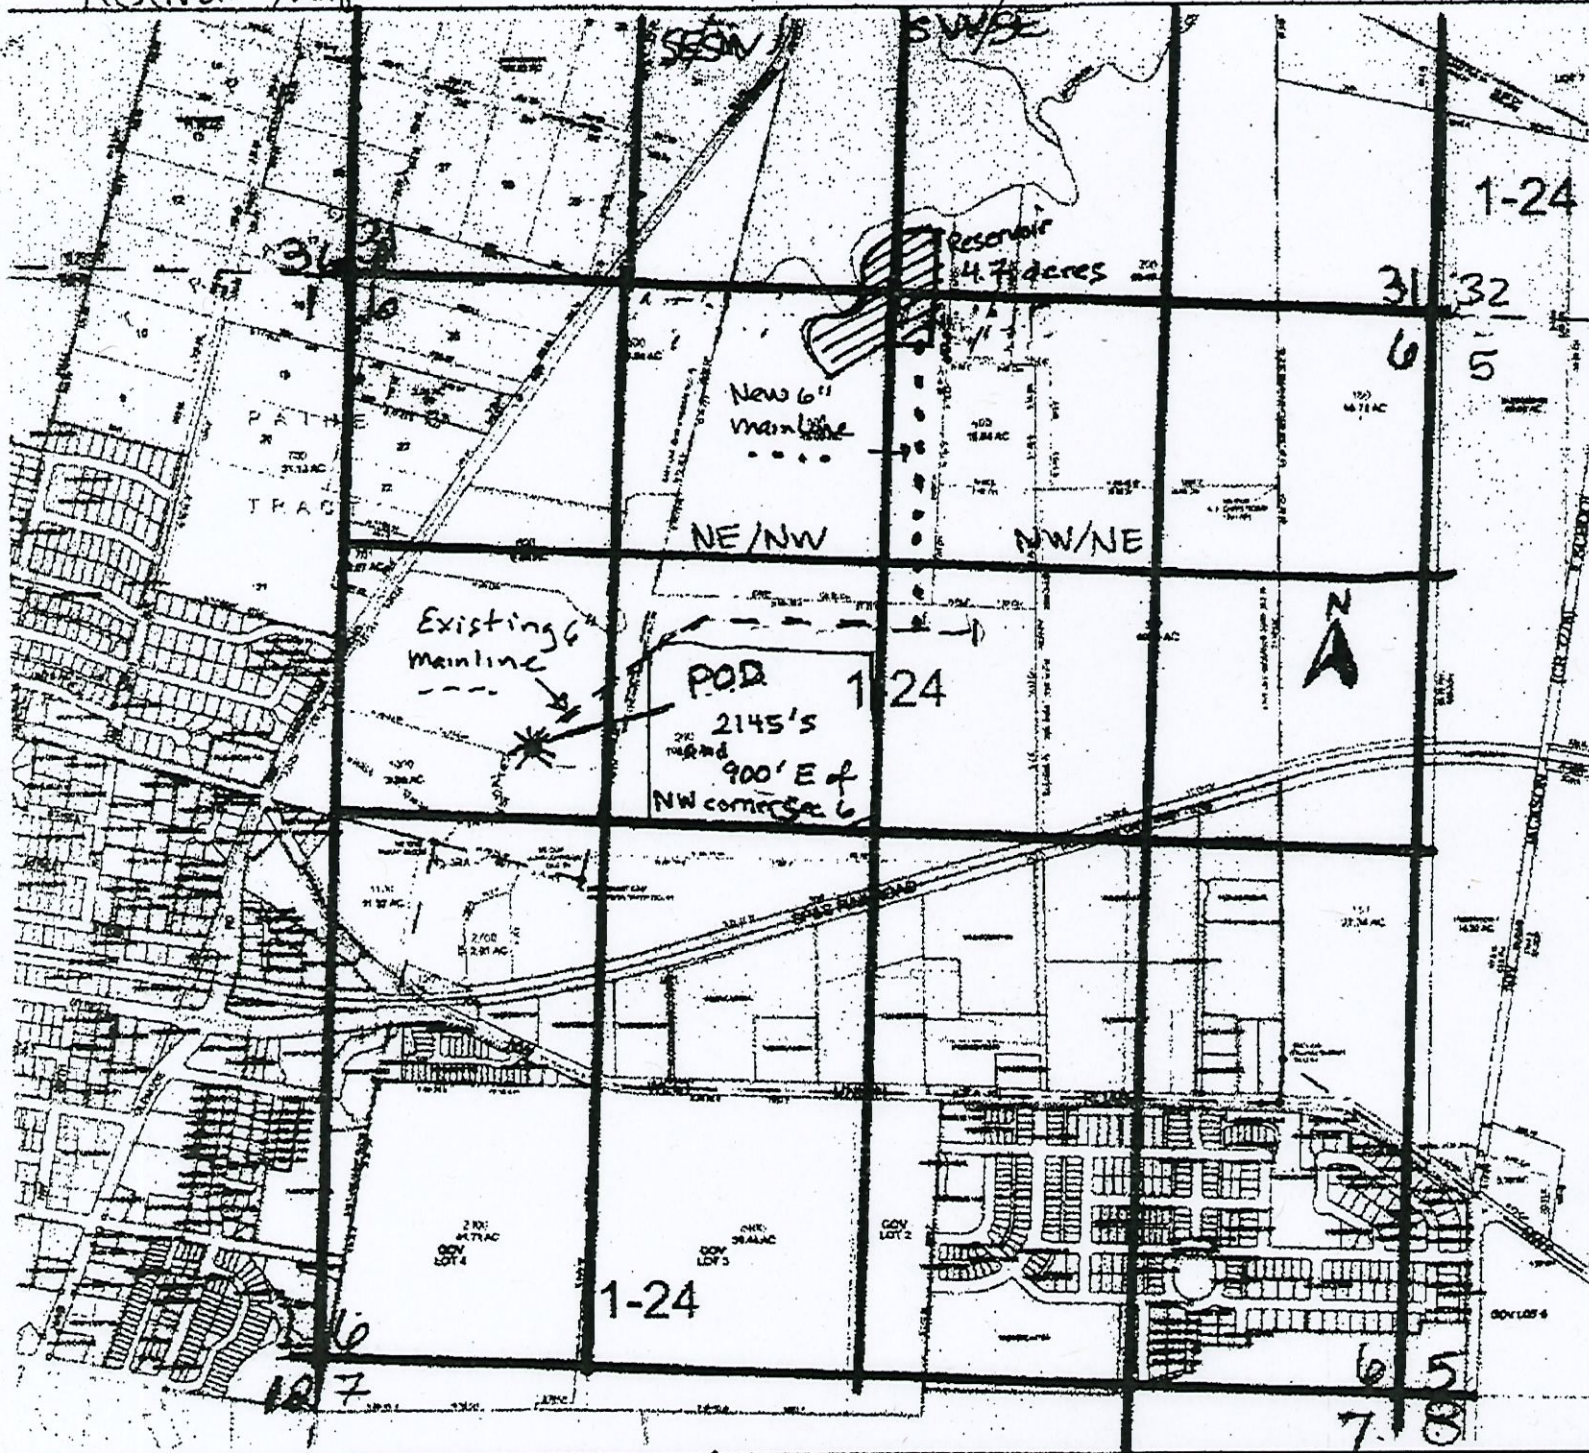

RECEIVED

1N205


NOV 22 2023

WASHINGTON COUNTY OREGON


SCALE 1" = 400'

OWRD

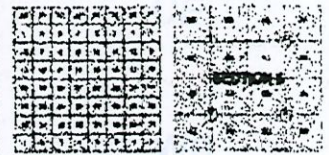

FOR ADDITIONAL MAPS VISIT OUR WEBSITE AT [www.co.wash.or.us](http://www.co.wash.or.us)


T R S Q/Q  
IN 2W 6 NE/NW

Tax Lot  
IN 26-00500

\* POD

Reservoir  
4.7 acres

Copyrighted Material For: 1/2005  

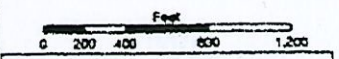

PLAN DATE: 11/2023  
FOR AMENDMENT PURPOSES  
ONLY. DO NOT RELY ON  
FOR OTHER USE.


1N205