


T.38 S.R.5 W.W.M.

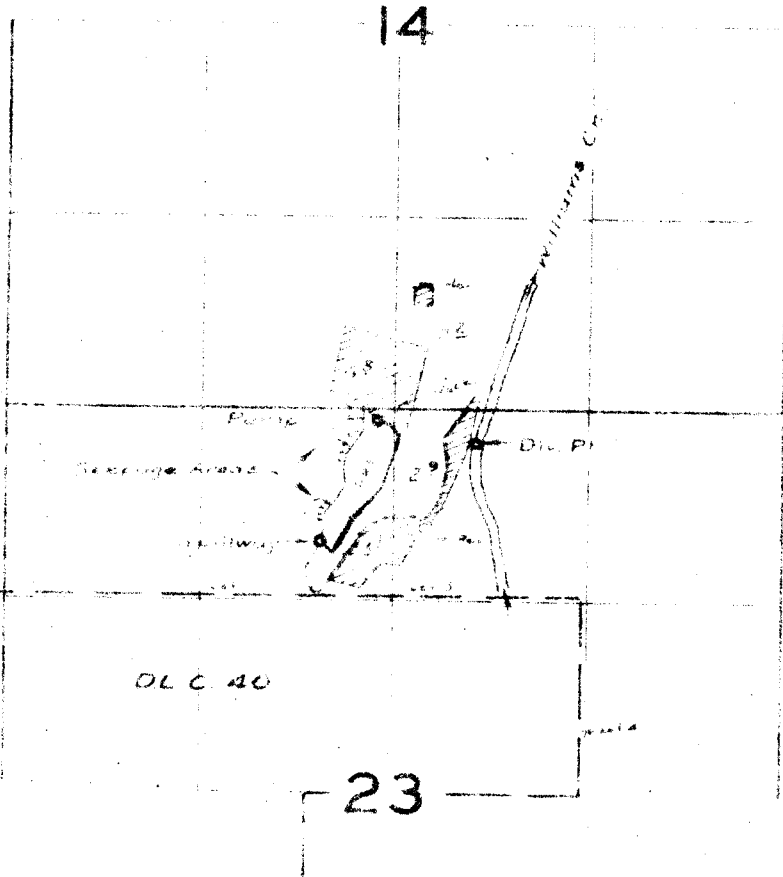

FINAL PROOF SURVEY UNDER

Application No. 187
 IN NAME OF
 Norman W. W...
 Surveyed and...