


38-5-1

R-1815

T.38 S. R.5 W.W.M.

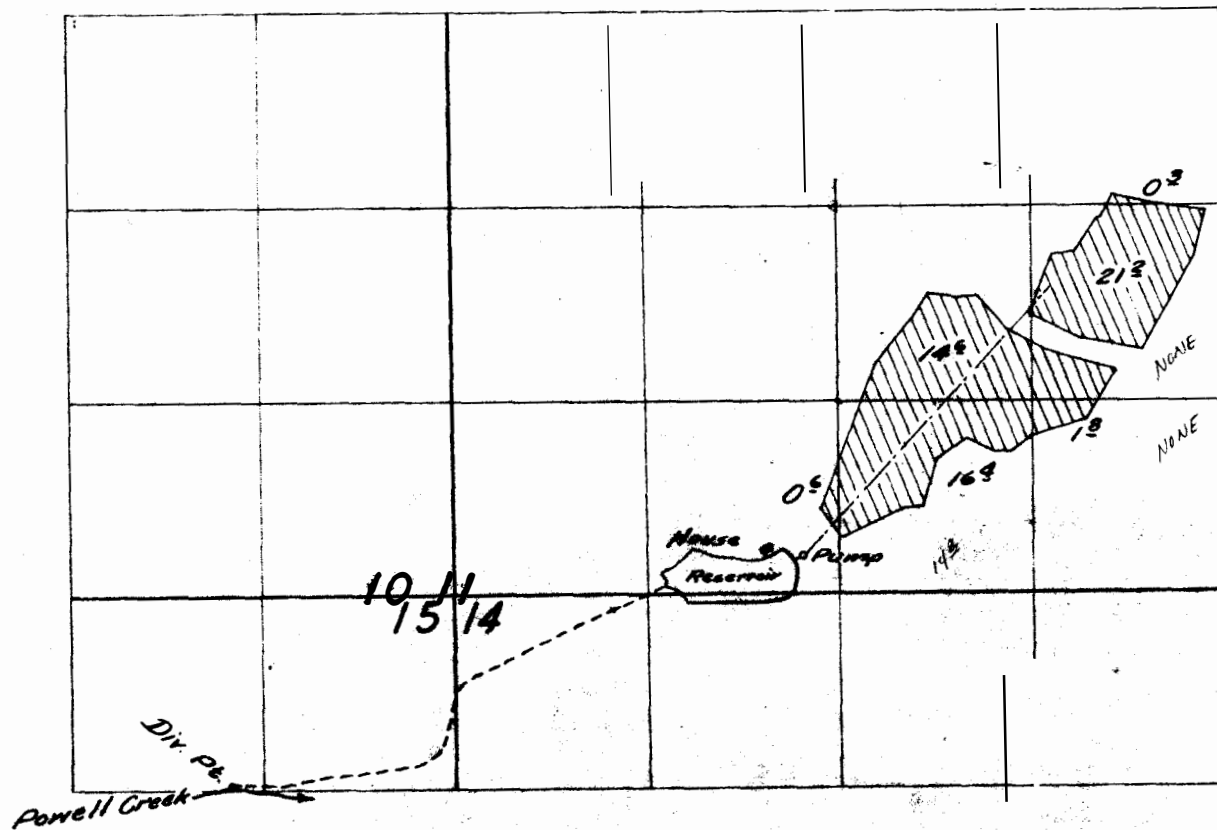

### FINAL PROOF SURVEY

UNDER

Application No. ~~30863~~ <sup>R-30862</sup> Permit No. ~~21106~~ <sup>R-21105</sup>

IN NAME OF

E. M. Liebeck

Surveyed July 19 59, by CBW:sto

38-5-11

1889-V