


T.39S.R.5W.W.M.

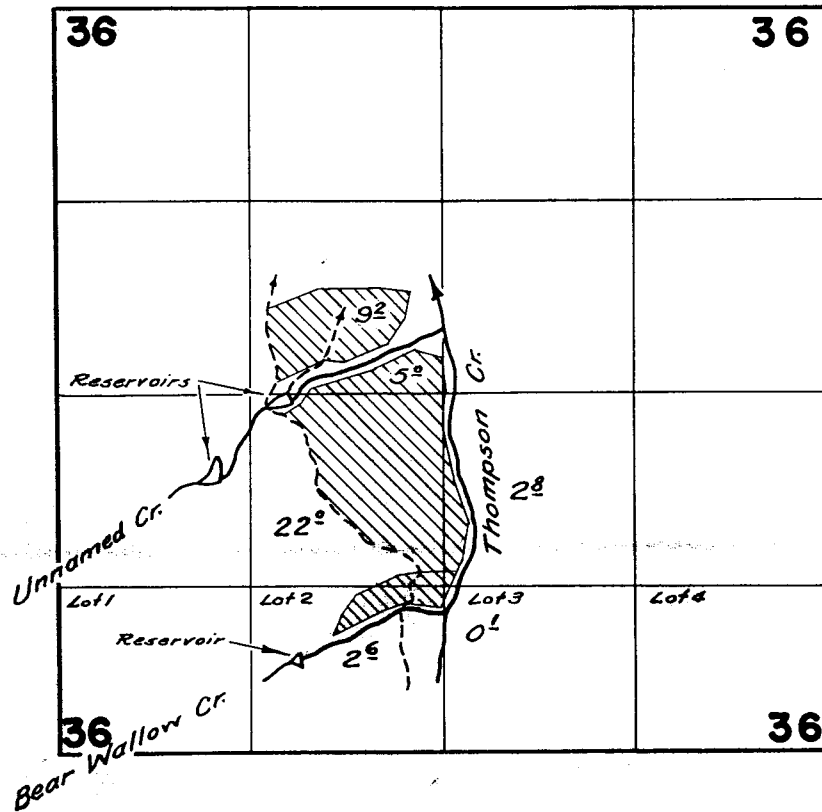

FINAL PROOF SURVEY UNDER

31180 24569
 R-31179 R-1957
 31178 24568
 Application No. ~~R-31177~~ Permit No. ~~R-1956~~
 IN NAME OF

RECEIVED

MAR 14 1991

WM. DIST. 14
GRANTS PASS, ORE.

.....FIELDS-STONE.....

Surveyed July 23, 1959, by C.O. Baitle.....