


RECEIVED
 NOV 13 1957
 STATE ENGINEER
 SALEM, OREGON

REGISTERED
 OREGON
 LAND SURVEYOR
 Arne Jarvi
 NOV 13 1957
 ARNE E. JARVI
 244

SURVEY # 246
 for
 H.E. Willman - Sec. 11 T8NR7W
 Sub-Division of Davis Estate
 WATER SYSTEM PIPELINE
 scale 1" = 200' 4/26/56

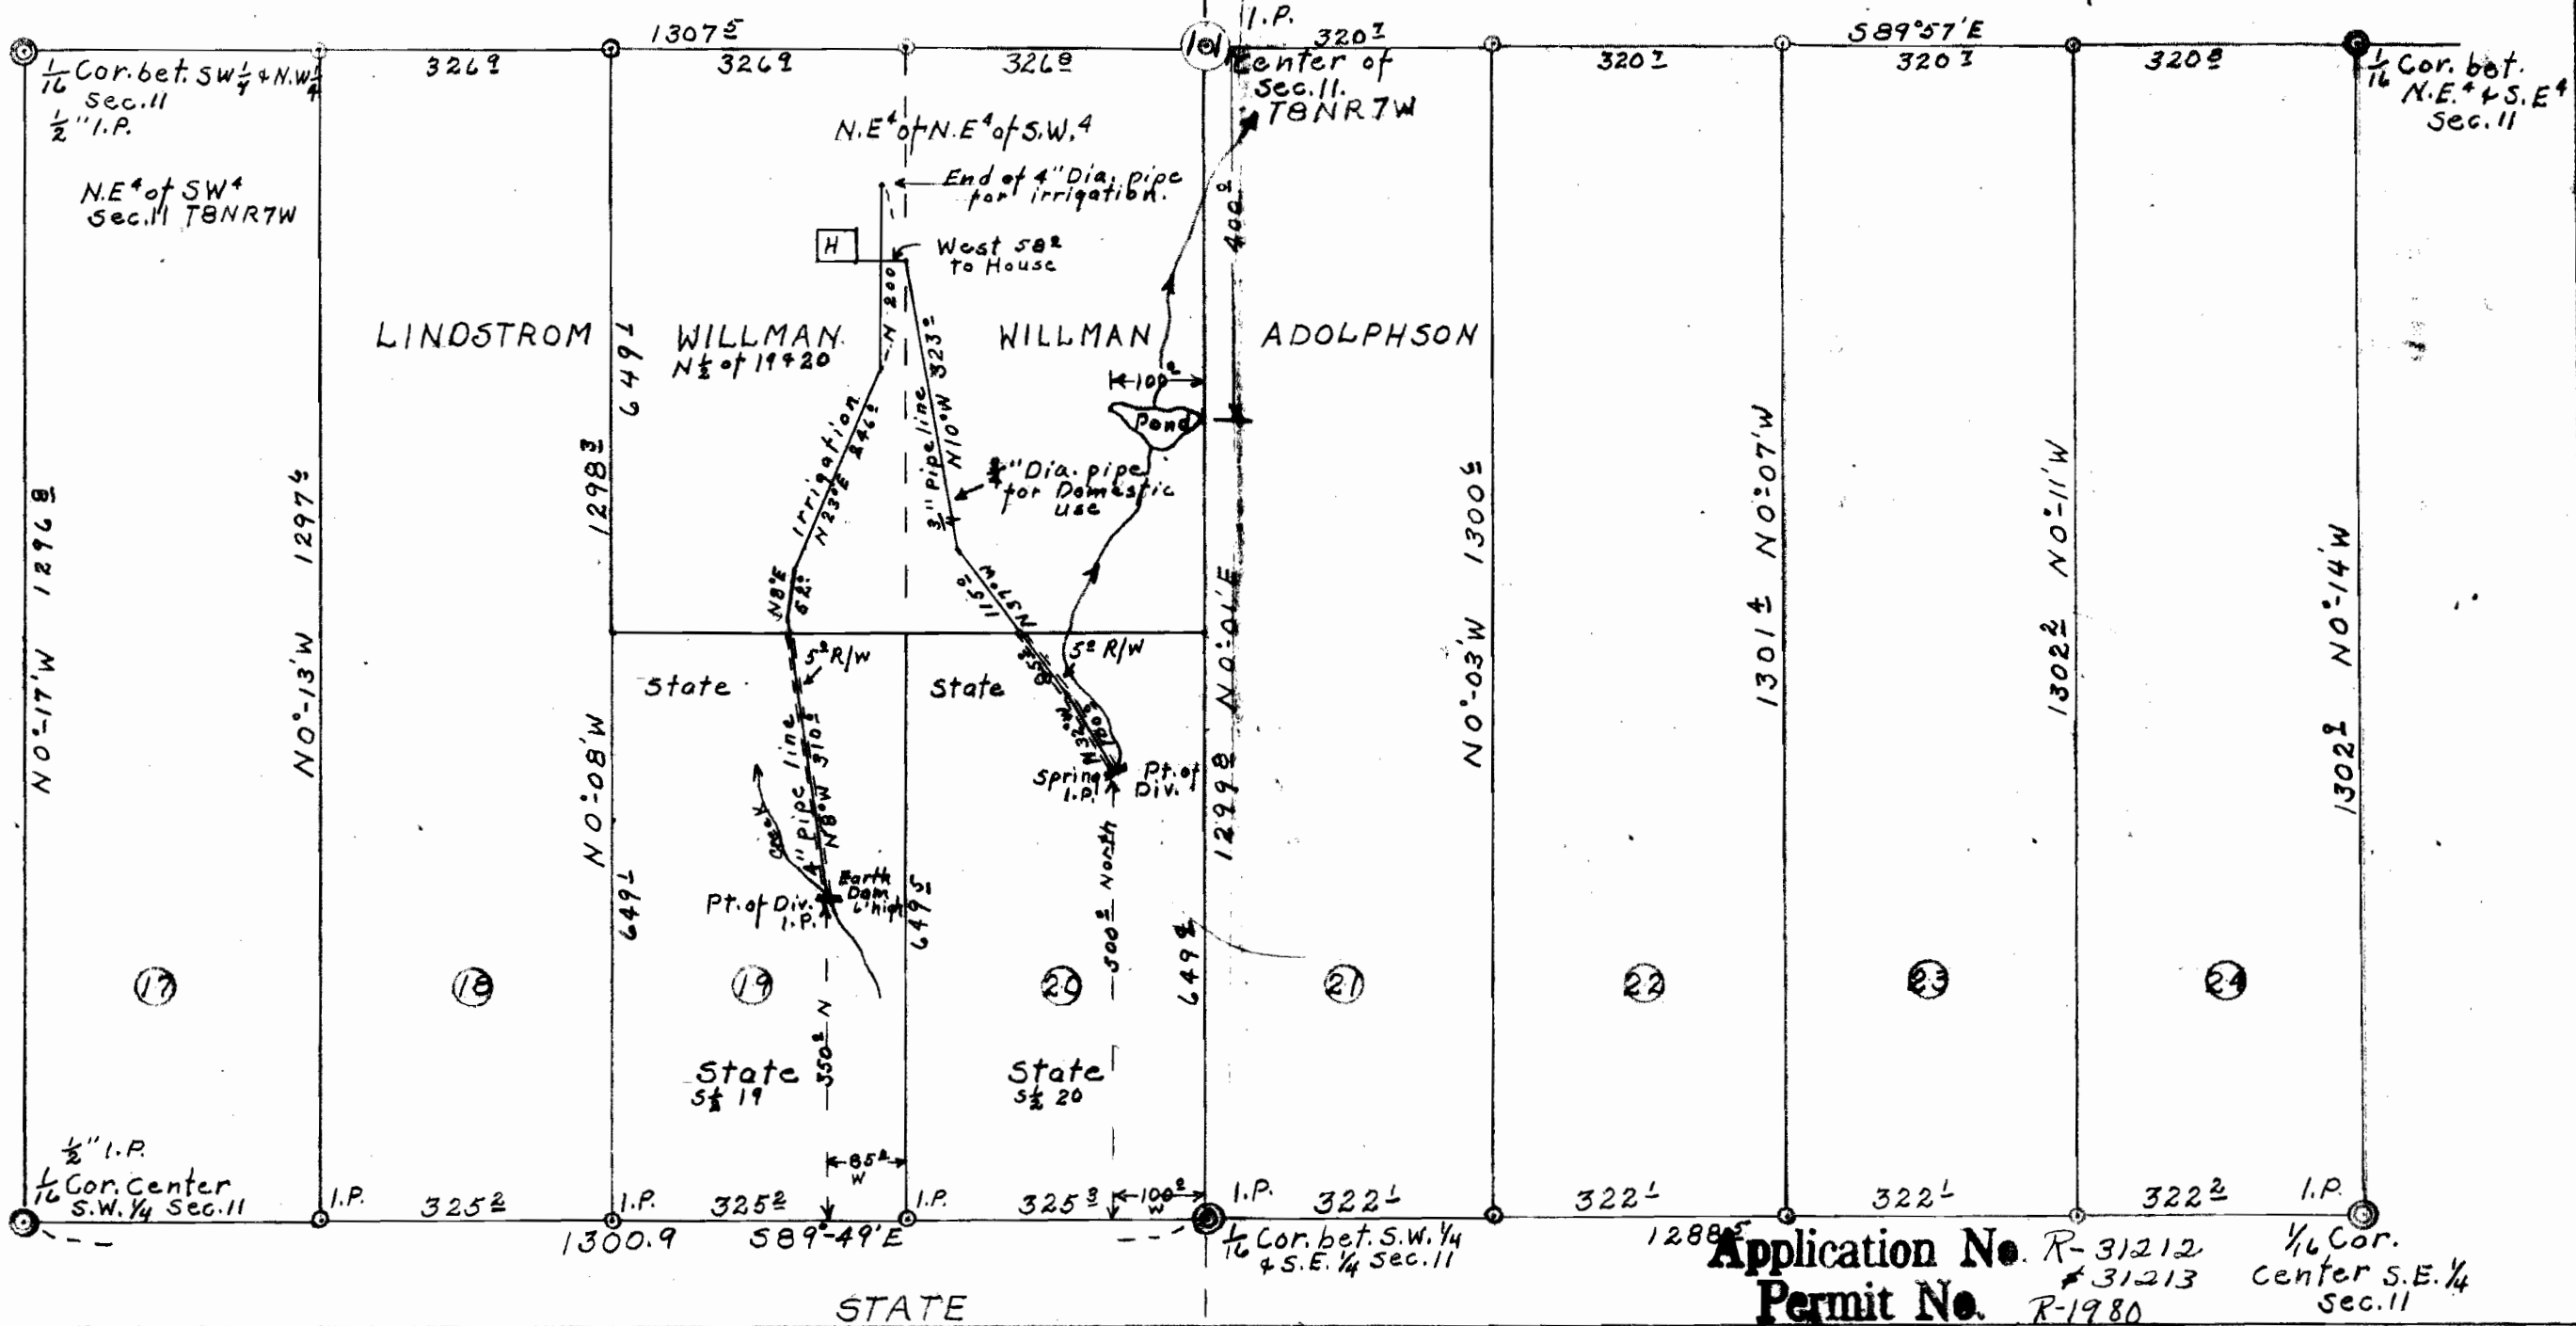

Application No. R-31212
 #31213
 Permit No. R-1980
 #24680

STATE