
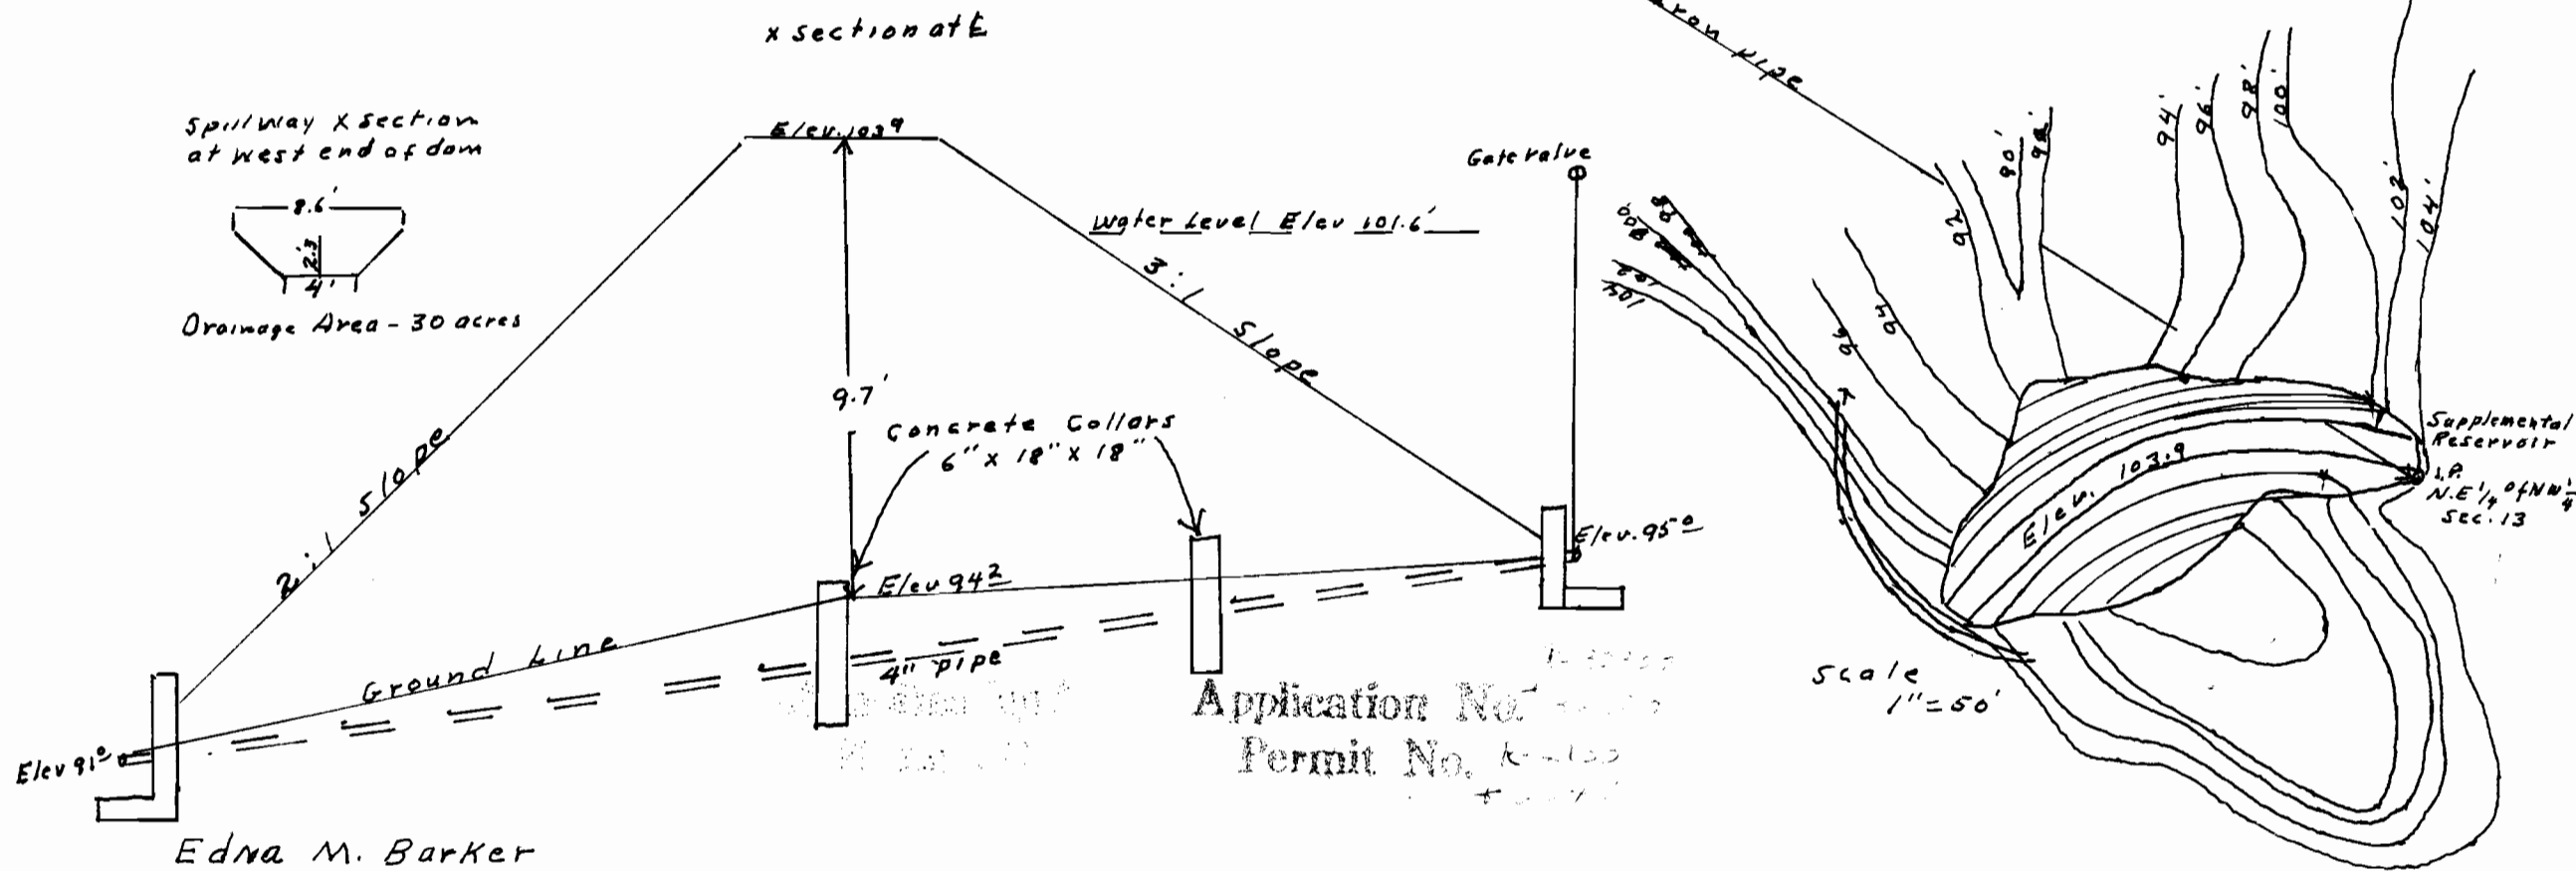
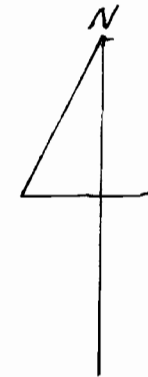


T-8 S. R. 4 W. W.M.

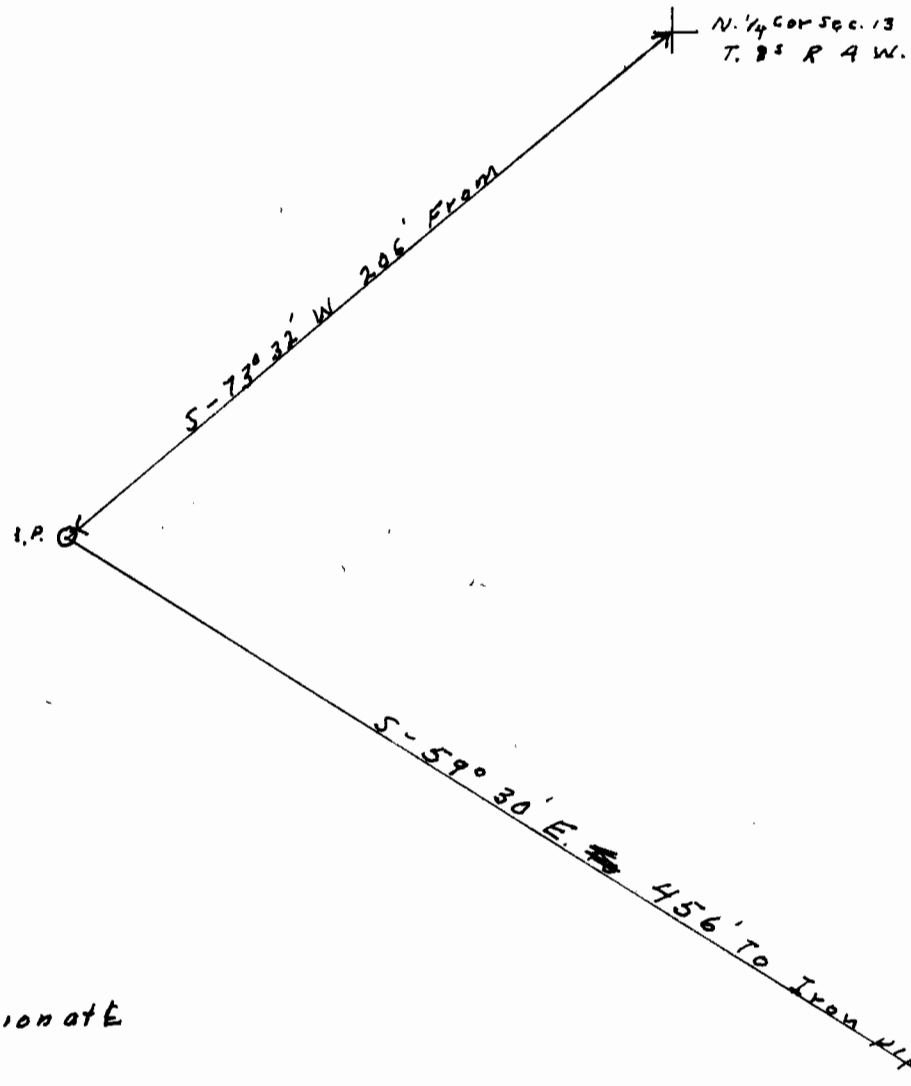

Santiam

4-30 - 1958